


T.2S.R.6E.W.M.

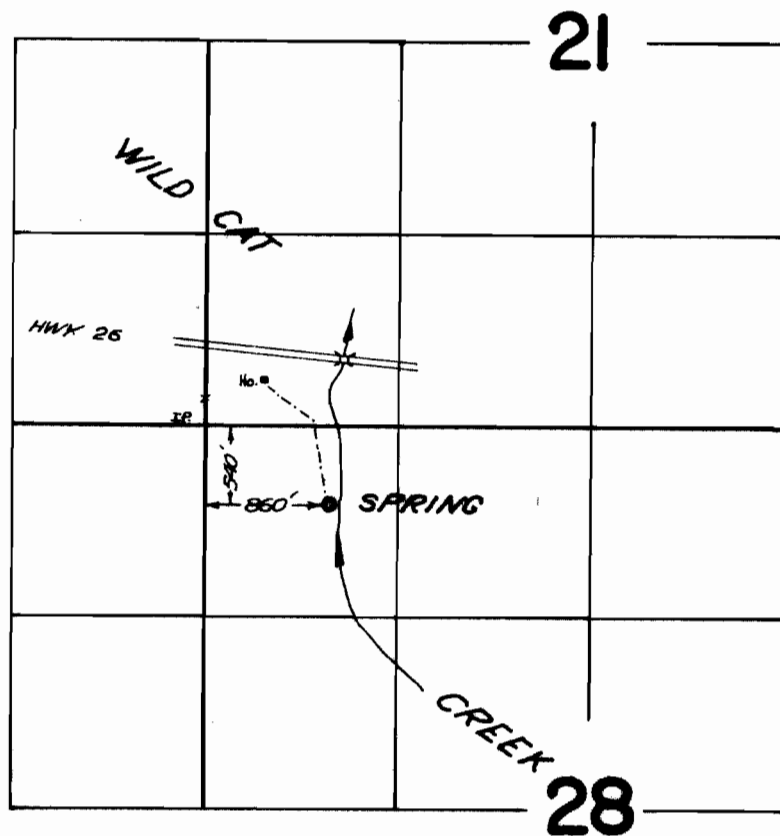

FINAL PROOF SURVEY
UNDER

Application No. 41267 Permit No. 30971
IN NAME OF

HALMER E. LIEN

Surveyed Aug 24 1966, by V. GARNER