


T.2&3S.R.4E.W.M.

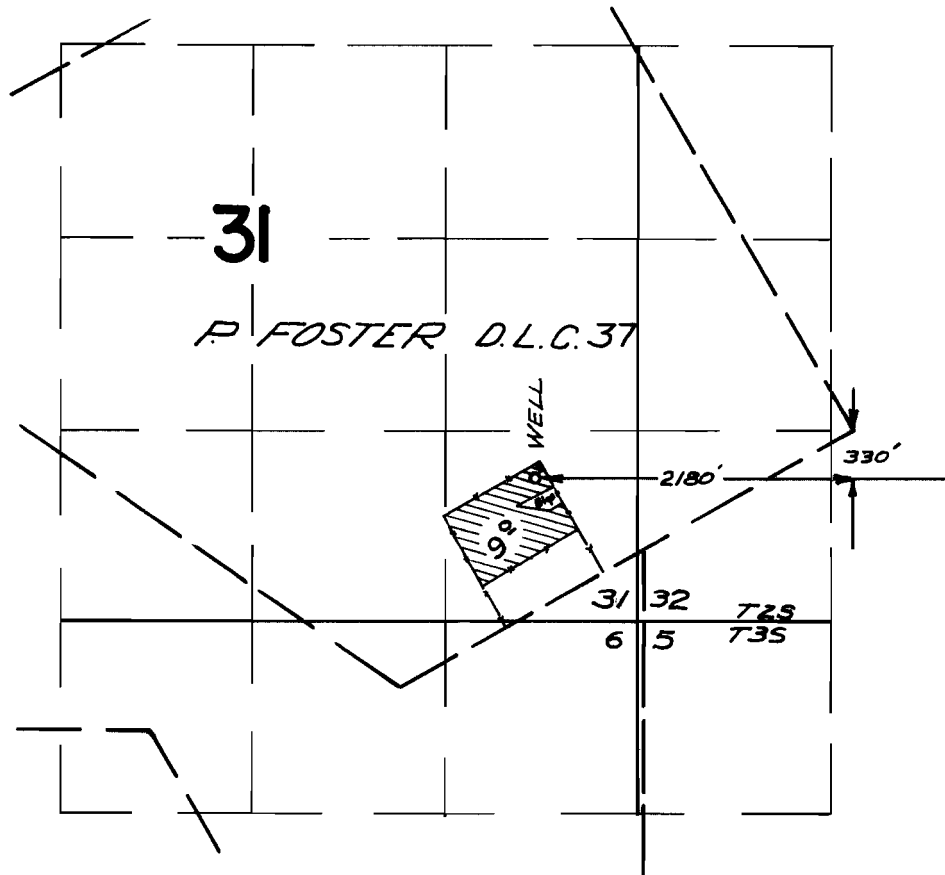

FINAL PROOF SURVEY UNDER

Application No. G-2476 Permit No. G-2287
IN NAME OF

ALFRED T. LINDLAND

Surveyed Aug. 26 1966, by V. GARNER