


T.1&2S. R.4 E. W.M.

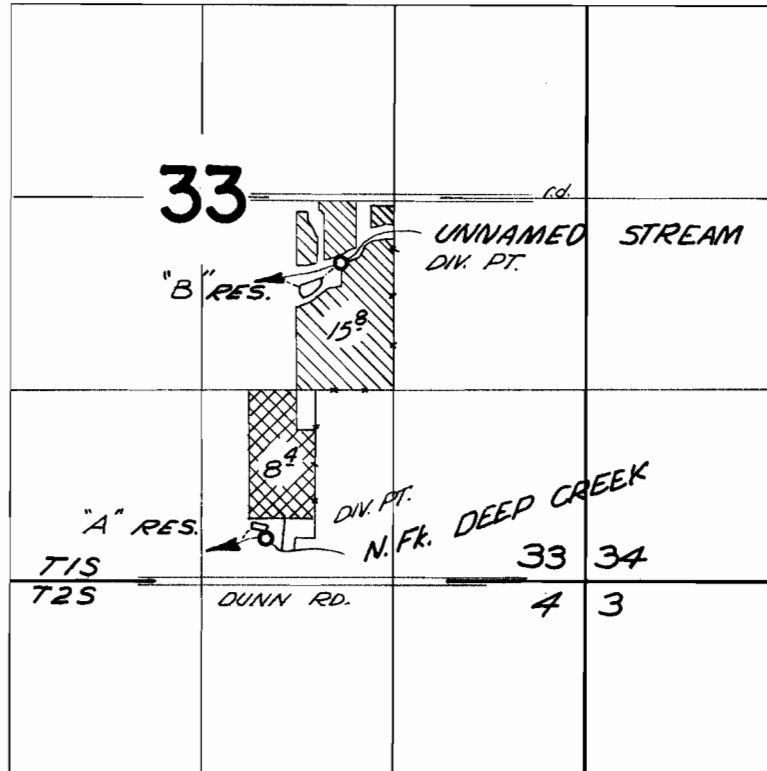

UNN. STREAM



N. FK. DEEP CR.

Div. Pts located 450 ft. S. & 370 ft. W., and 2350 ft. S. & 880 ft. W., Both from the N.E. cor. NW $\frac{1}{4}$, SE $\frac{1}{4}$ of Section 33

FINAL PROOF SURVEY UNDER

R-38128

R-3147

Application No. 37923 Permit No. 28293
IN NAME OF

KIYOMITSU MIYAKE

Surveyed Aug 23 1966, by V. GARNER