


T.5S.R.1&2E.W.M.

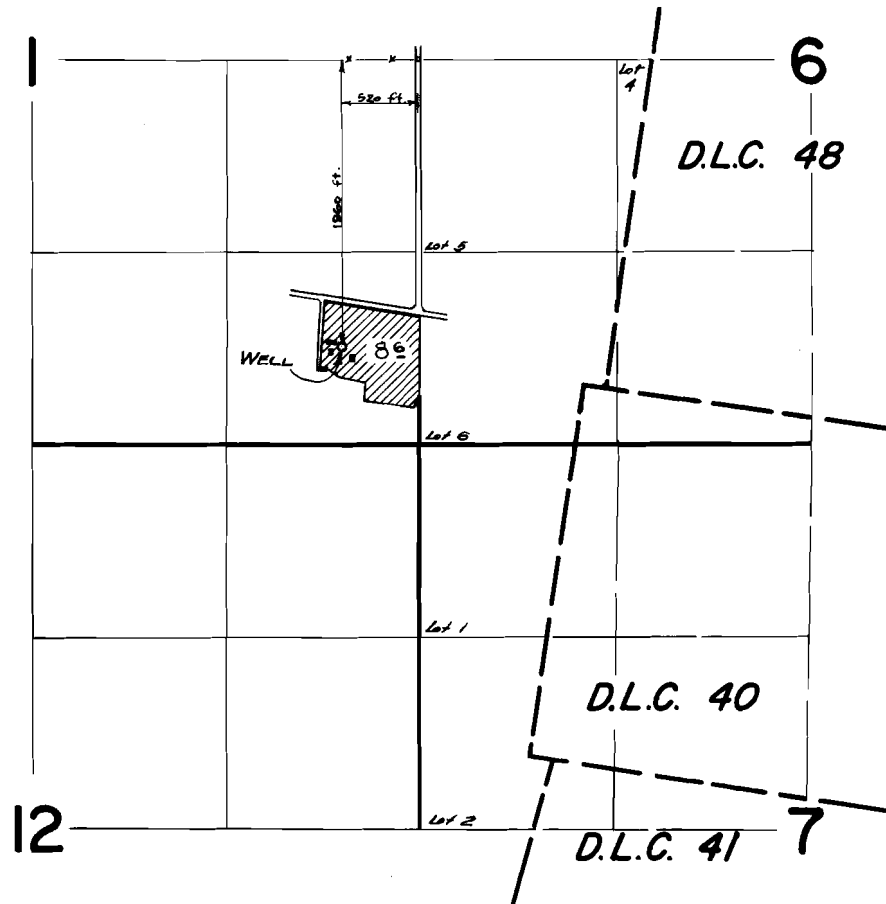

FINAL PROOF SURVEY
UNDER

Application No. G-2112 Permit No. G-1948
IN NAME OF

RICHARD & LUELLA M. WILLIAMS

Surveyed April 13, 1965, by

R. H. Jackson