


# T.27 & 28 S. R.11 W. W.M.

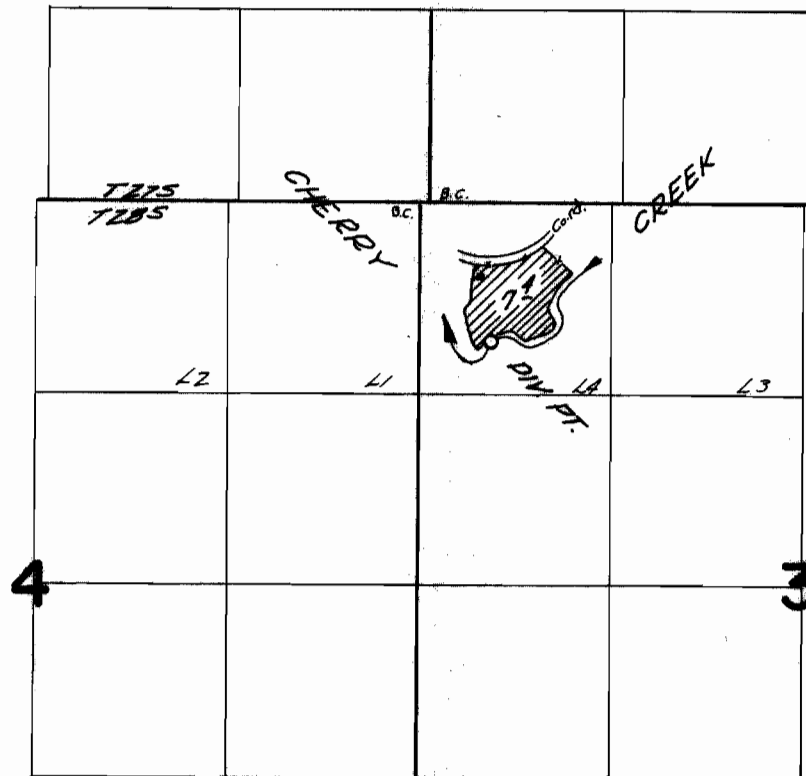

Div. Pt. located 960 ft. S. & 490 ft. E. from  
the N.W. corner of Section 3

## FINAL PROOF SURVEY UNDER

Application No. 34021 Permit No. 26831  
IN NAME OF

CHARLES GILL

Surveyed Oct. 11, 1966, by V. GARNER