


T.27S.R.5W.W.M.

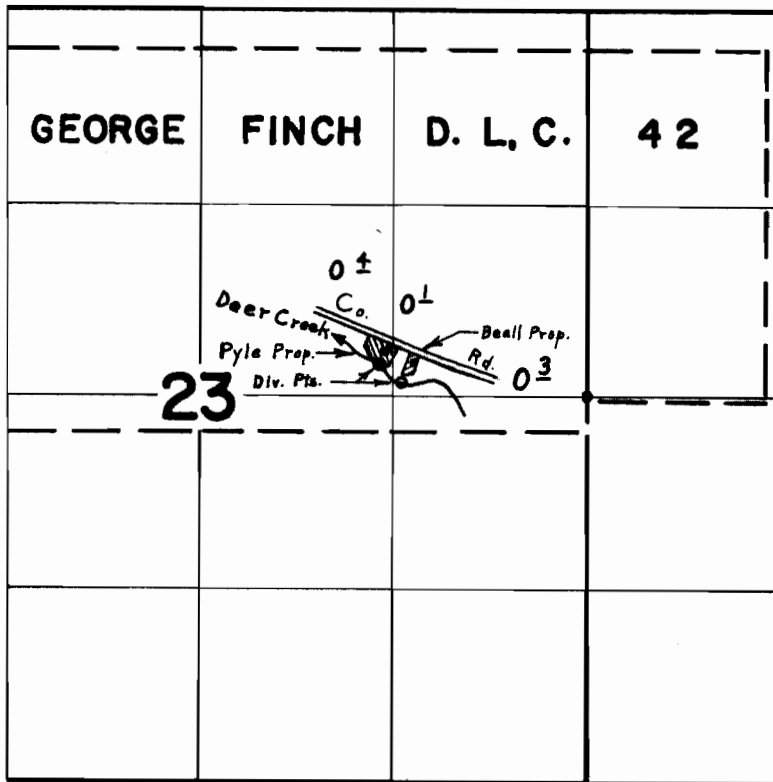

N. Div. Pt. Located 210' N. & 1410' W., S. Pt. Located 90' N. & 1270' W.
Both From E. $\frac{1}{4}$ Cor. Sec. 23

FINAL PROOF SURVEY UNDER

Application No. 41316 Permit No. 30851
IN NAME OF
T. E. & OPAL BEALL
WELCOME WILLIAM & MARION HEATHER PYLE

Surveyed May 17, 1966, by L. E. Gauld.....