


# T.21S.R.4W.W.M.

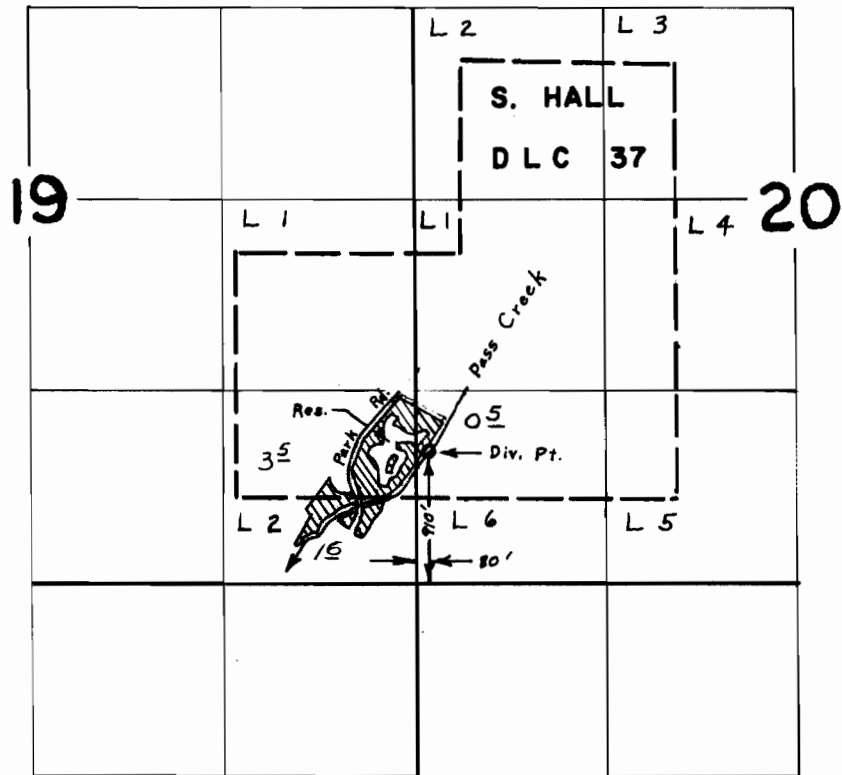

## FINAL PROOF SURVEY UNDER

R-40312                      R-4612  
Application No. 40313 Permit No. 30625  
IN NAME OF

DOUGLAS COUNTY

Surveyed May 13 1966, by L. E. Gould