


6
P-28038
34343

T.9S.R.31E.W.M.

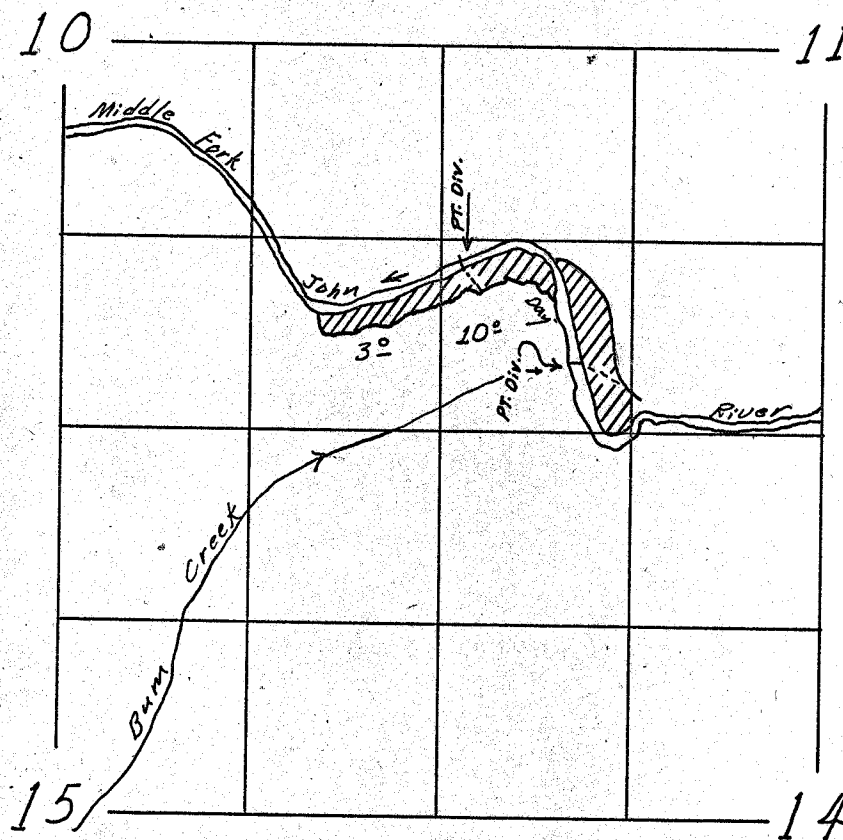

FINAL PROOF SURVEY
UNDER

Application No. 37570 Permit No. 28038
IN NAME OF

ROBERT C. or ALTHEA GIBBS

Surveyed Aug. 6 1965, by G. Ward

4-1965-C