


T.34 S.R.IW,W.M.

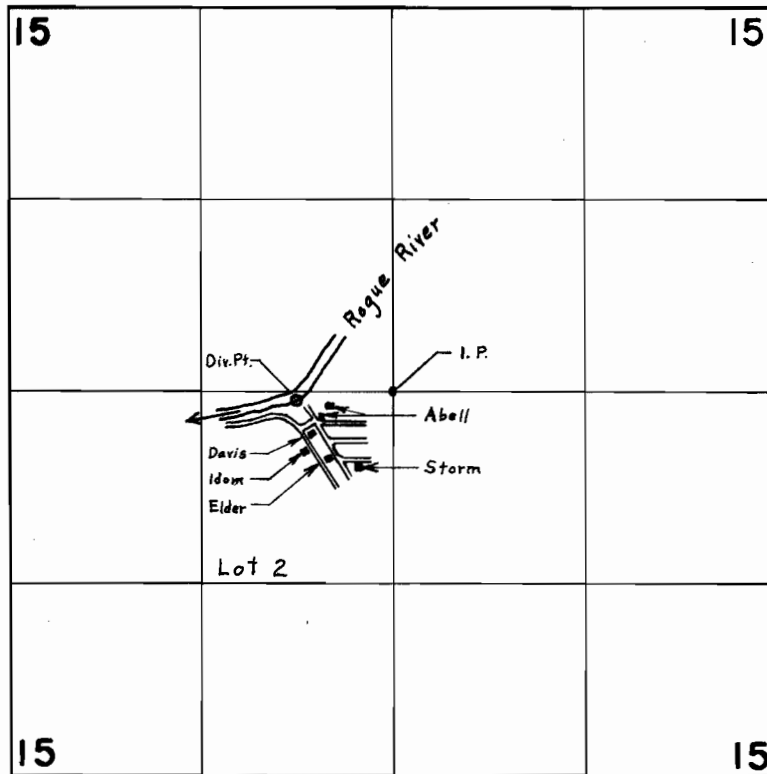

Div. Pt. Located 670' W. & 60' S. From Center Sec. 15

FINAL PROOF SURVEY UNDER

Application No. 38366 Permit No. 28592
IN NAME OF

COVE WATER USERS

Surveyed July 12, 1966, by L. E. Gould