


T.34S.R.IW.W.M.

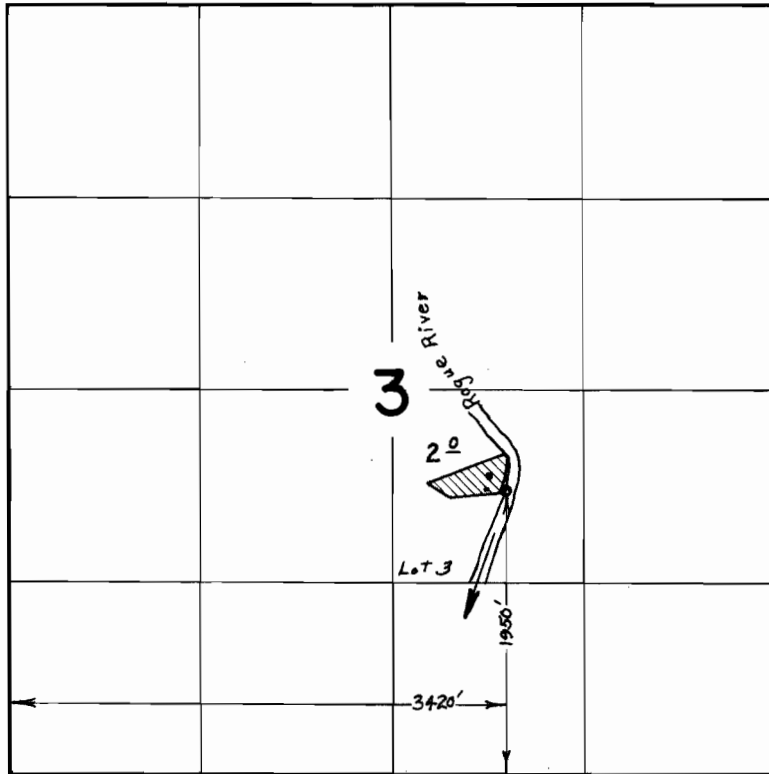

FINAL PROOF SURVEY
UNDER

Application No. 37200 Permit No. 27723
IN NAME OF

ARCHIE A. & GENEVIEVE L. GILLOW

Surveyed July 14, 1966, by L. E. Gould