


T.37 S.R.4 W.W.M.

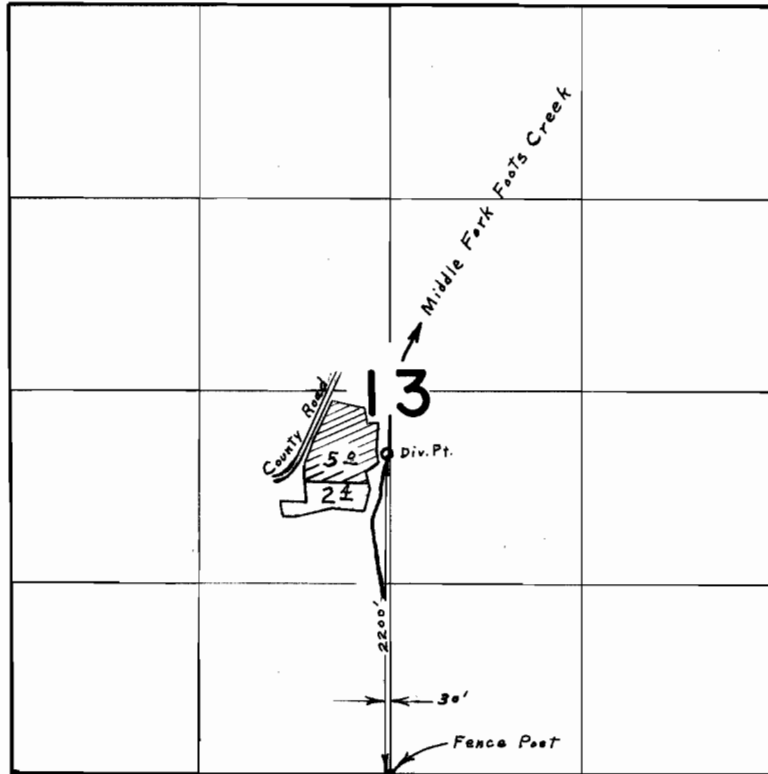

**FINAL PROOF SURVEY**  
UNDER

Application No. 37453 Permit No. 27884  
IN NAME OF

MAXWELL L. THAYER

Surveyed June 8, 1966, by L. E. Gould