


# T.34S.R.1E.W.M.

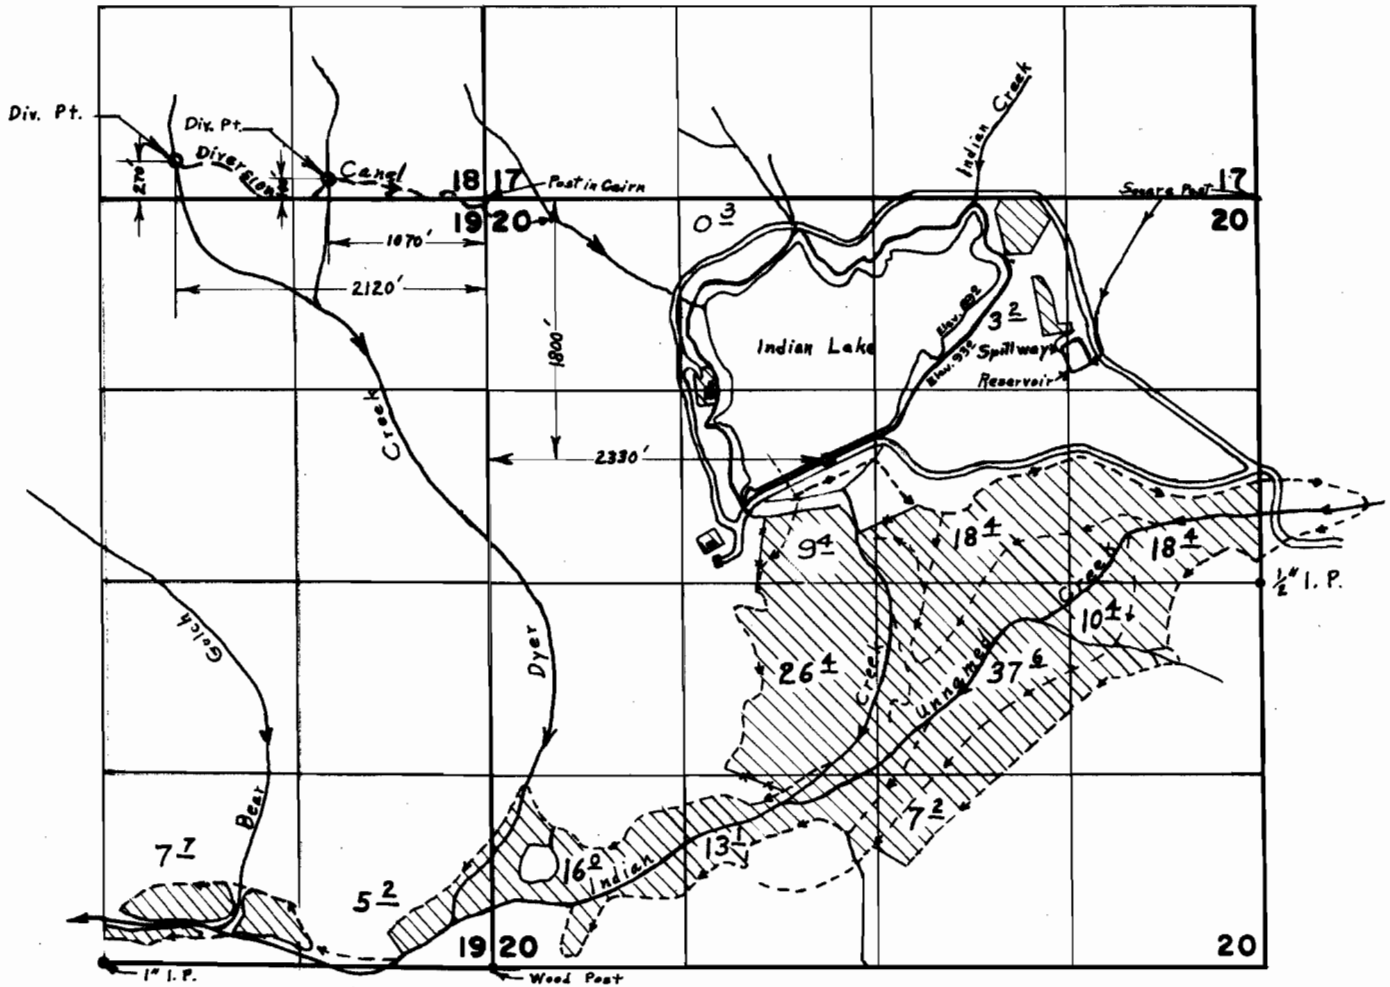

## FINAL PROOF SURVEY UNDER

R-26790                      R-1459  
 Application No. 26791... Permit No. 21925...  
 IN NAME OF

WM. B. & BOB L. WALCH

Surveyed July 19, 1966, by L. E. Gould