


T.35S. R.6W.W.M.

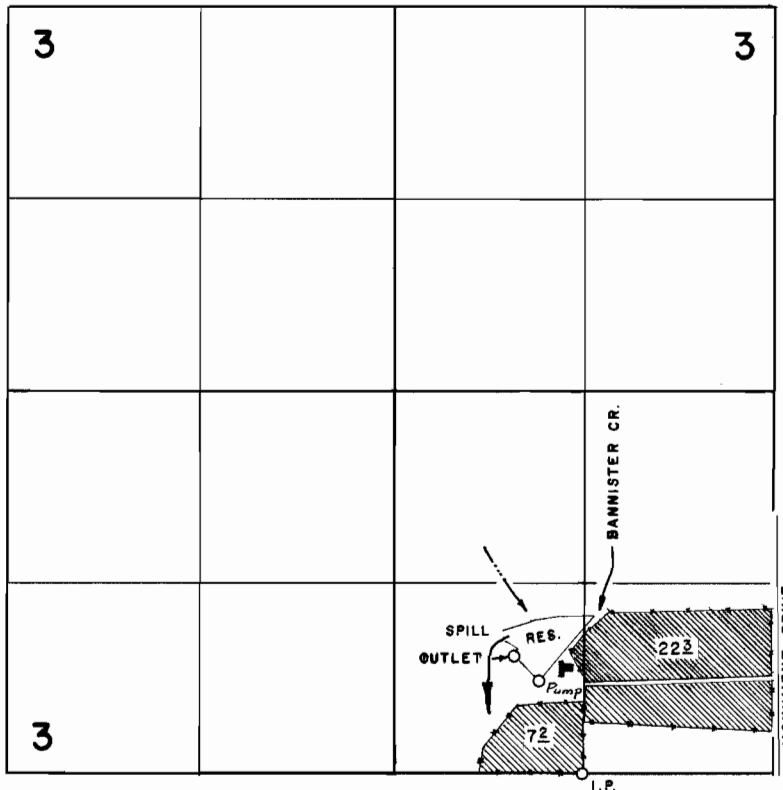

*Div. Pt. located 800 ft. N. & 480 ft. W. from
the S.E. Cor. SW 1/4 SE 1/4 Sec. 3*

FINAL PROOF SURVEY UNDER

R-37371 R-3246
Application No. 37372 Permit No. 28695
IN NAME OF

JOEL L. BARKER

Surveyed May 23, 1967, by R.B. STEIMER