
## T.40S.R.8&9W.W.M.

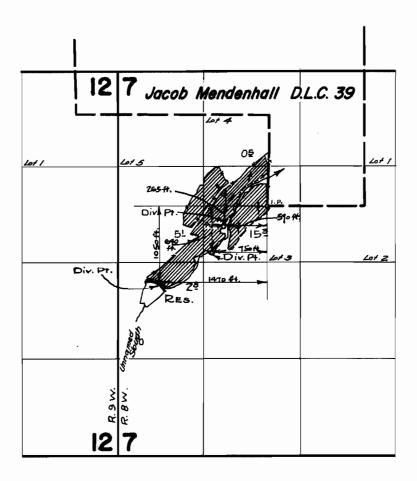

## FINAL PROOF SURVEY

R-37030 R-2662 Application No. 37031 Permit No. 27563 IN NAME OF

EITEL F. MUSSELMAN

Surveyed Juna 22 1965, by Affackson