


T.40S.R.88&9W.W.M.

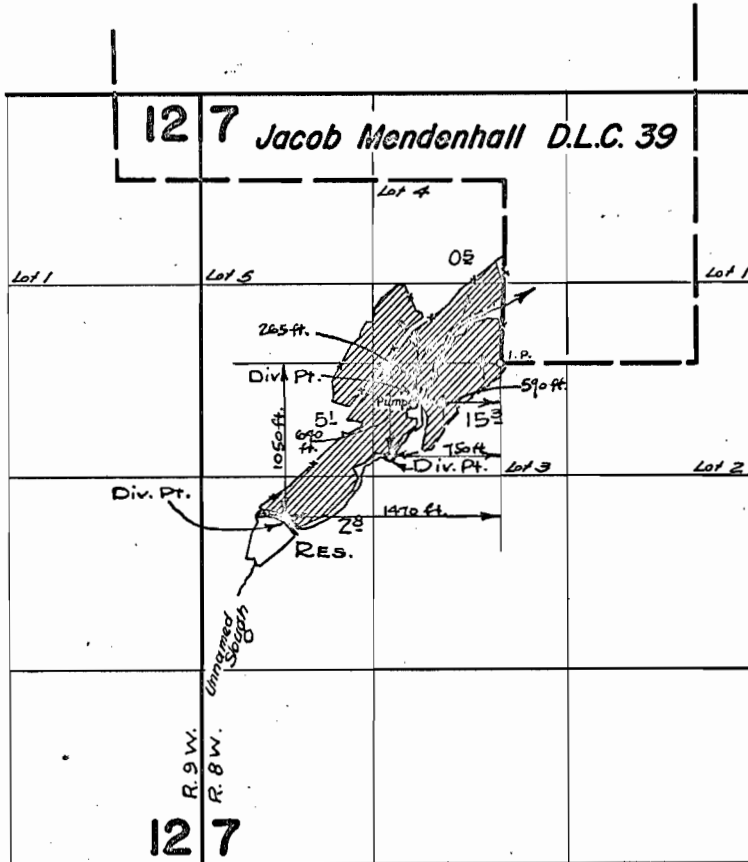

**FINAL PROOF SURVEY**  
UNDER

R-37030                      R-2662  
Application No. 37031... Permit No. 27563...  
IN NAME OF

..... EITEL F. MUSSELMAN .....

Surveyed June 22 1965, by *A. Jackson*