


# T.35 S. R. 7 W. W.M.

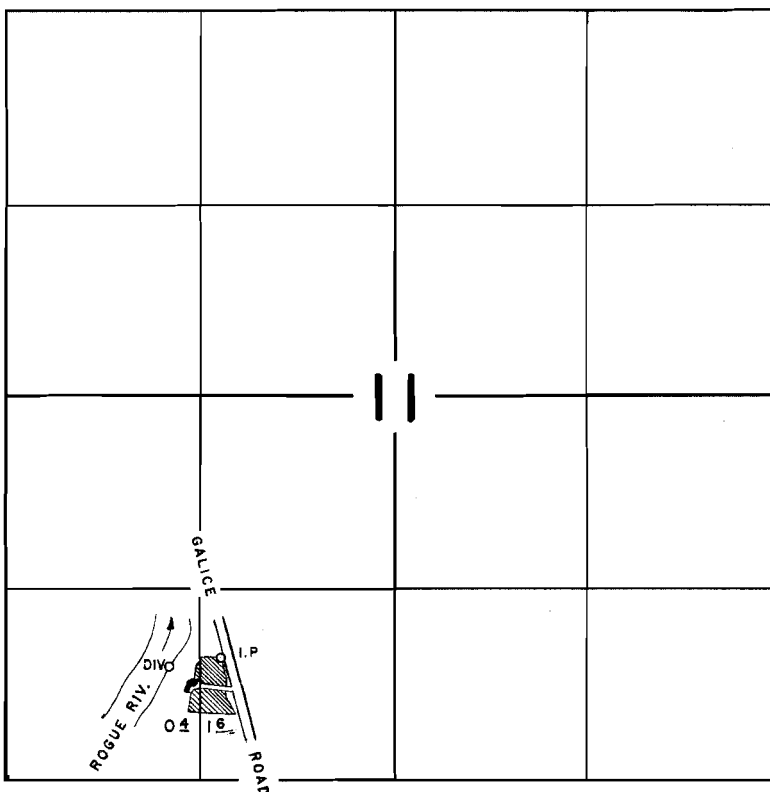

Div. Pt. located 1120' E. & 770' N. from S.W. Cor. Sec. 11

## FINAL PROOF SURVEY UNDER

Application No. 39976 Permit No. 29746  
IN NAME OF

TODD & EDITH C. GILMORE

Surveyed May 23, 1967, by R.B. STEIMER