

R-1758

10/2

34364

T.39

Appl. R-30068

30067

R-32558

32700

Per. R-1758

23659


R-2184

25760

F

BU

SI

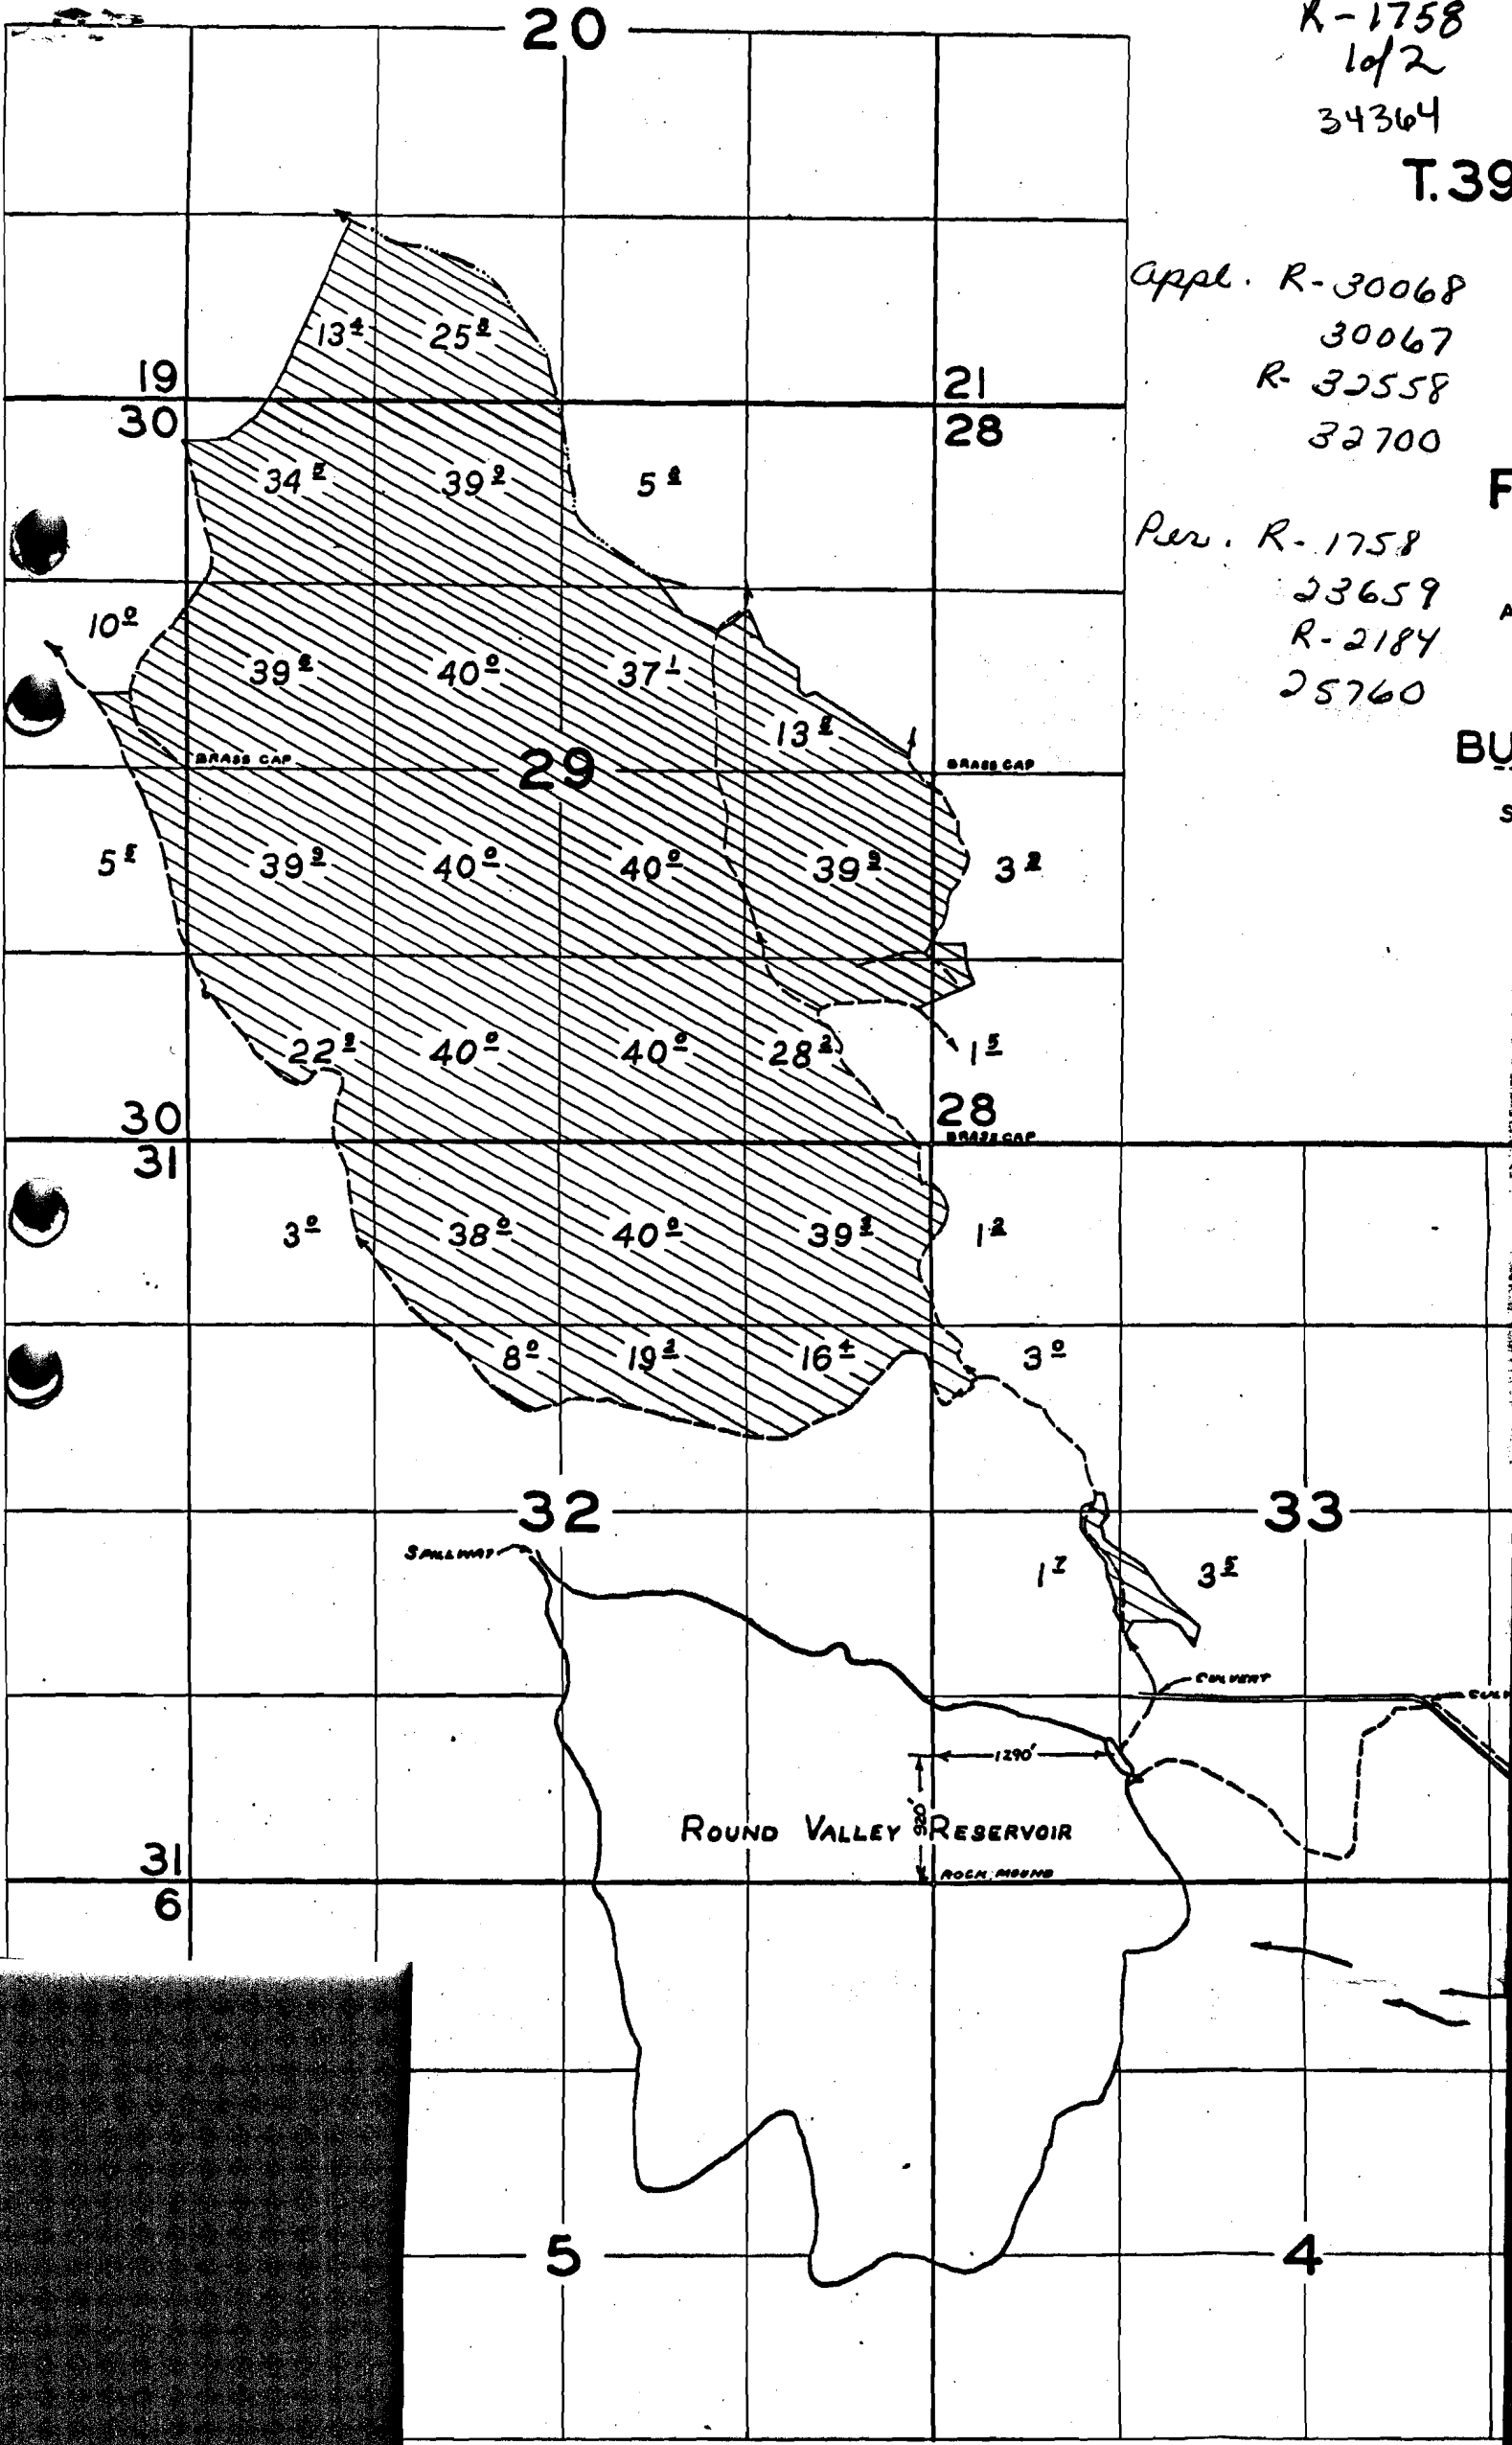

R-1758

292

T.39 & 40 S. R.14 & 14½ E. W.M.

FINAL PROOF SURVEY

UNDER

R-30066
30067
R-32558

R-1758
23650
R-2184
25760

APPLICATION NO. 32700 PERMIT NO. 25760

IN NAME OF
U.S. DEPT. OF INTERIOR
BUREAU OF LAND MANAGEMENT

SURVEYED JUL 24 1964, BY R. JACKSON
Insp. June 20 1967, BY V. Gerner

21
28



BRASS CAP

32

12

28

BRASS CAP



32

33

34

3250 ft.

12 32

CULVERT

CULVERTS

CULVERT

Div. Pt. Wilderness Creek

2040 ft.

RESERVOIR

ROCK MOUND

BRASS CAP

T. 39 S. R. 14 E. W.M.
T. 40 S. R. 14½ E. W.M.

1600 ft.

Div. Pt.

770 ft.

Unmarked System

4

3