


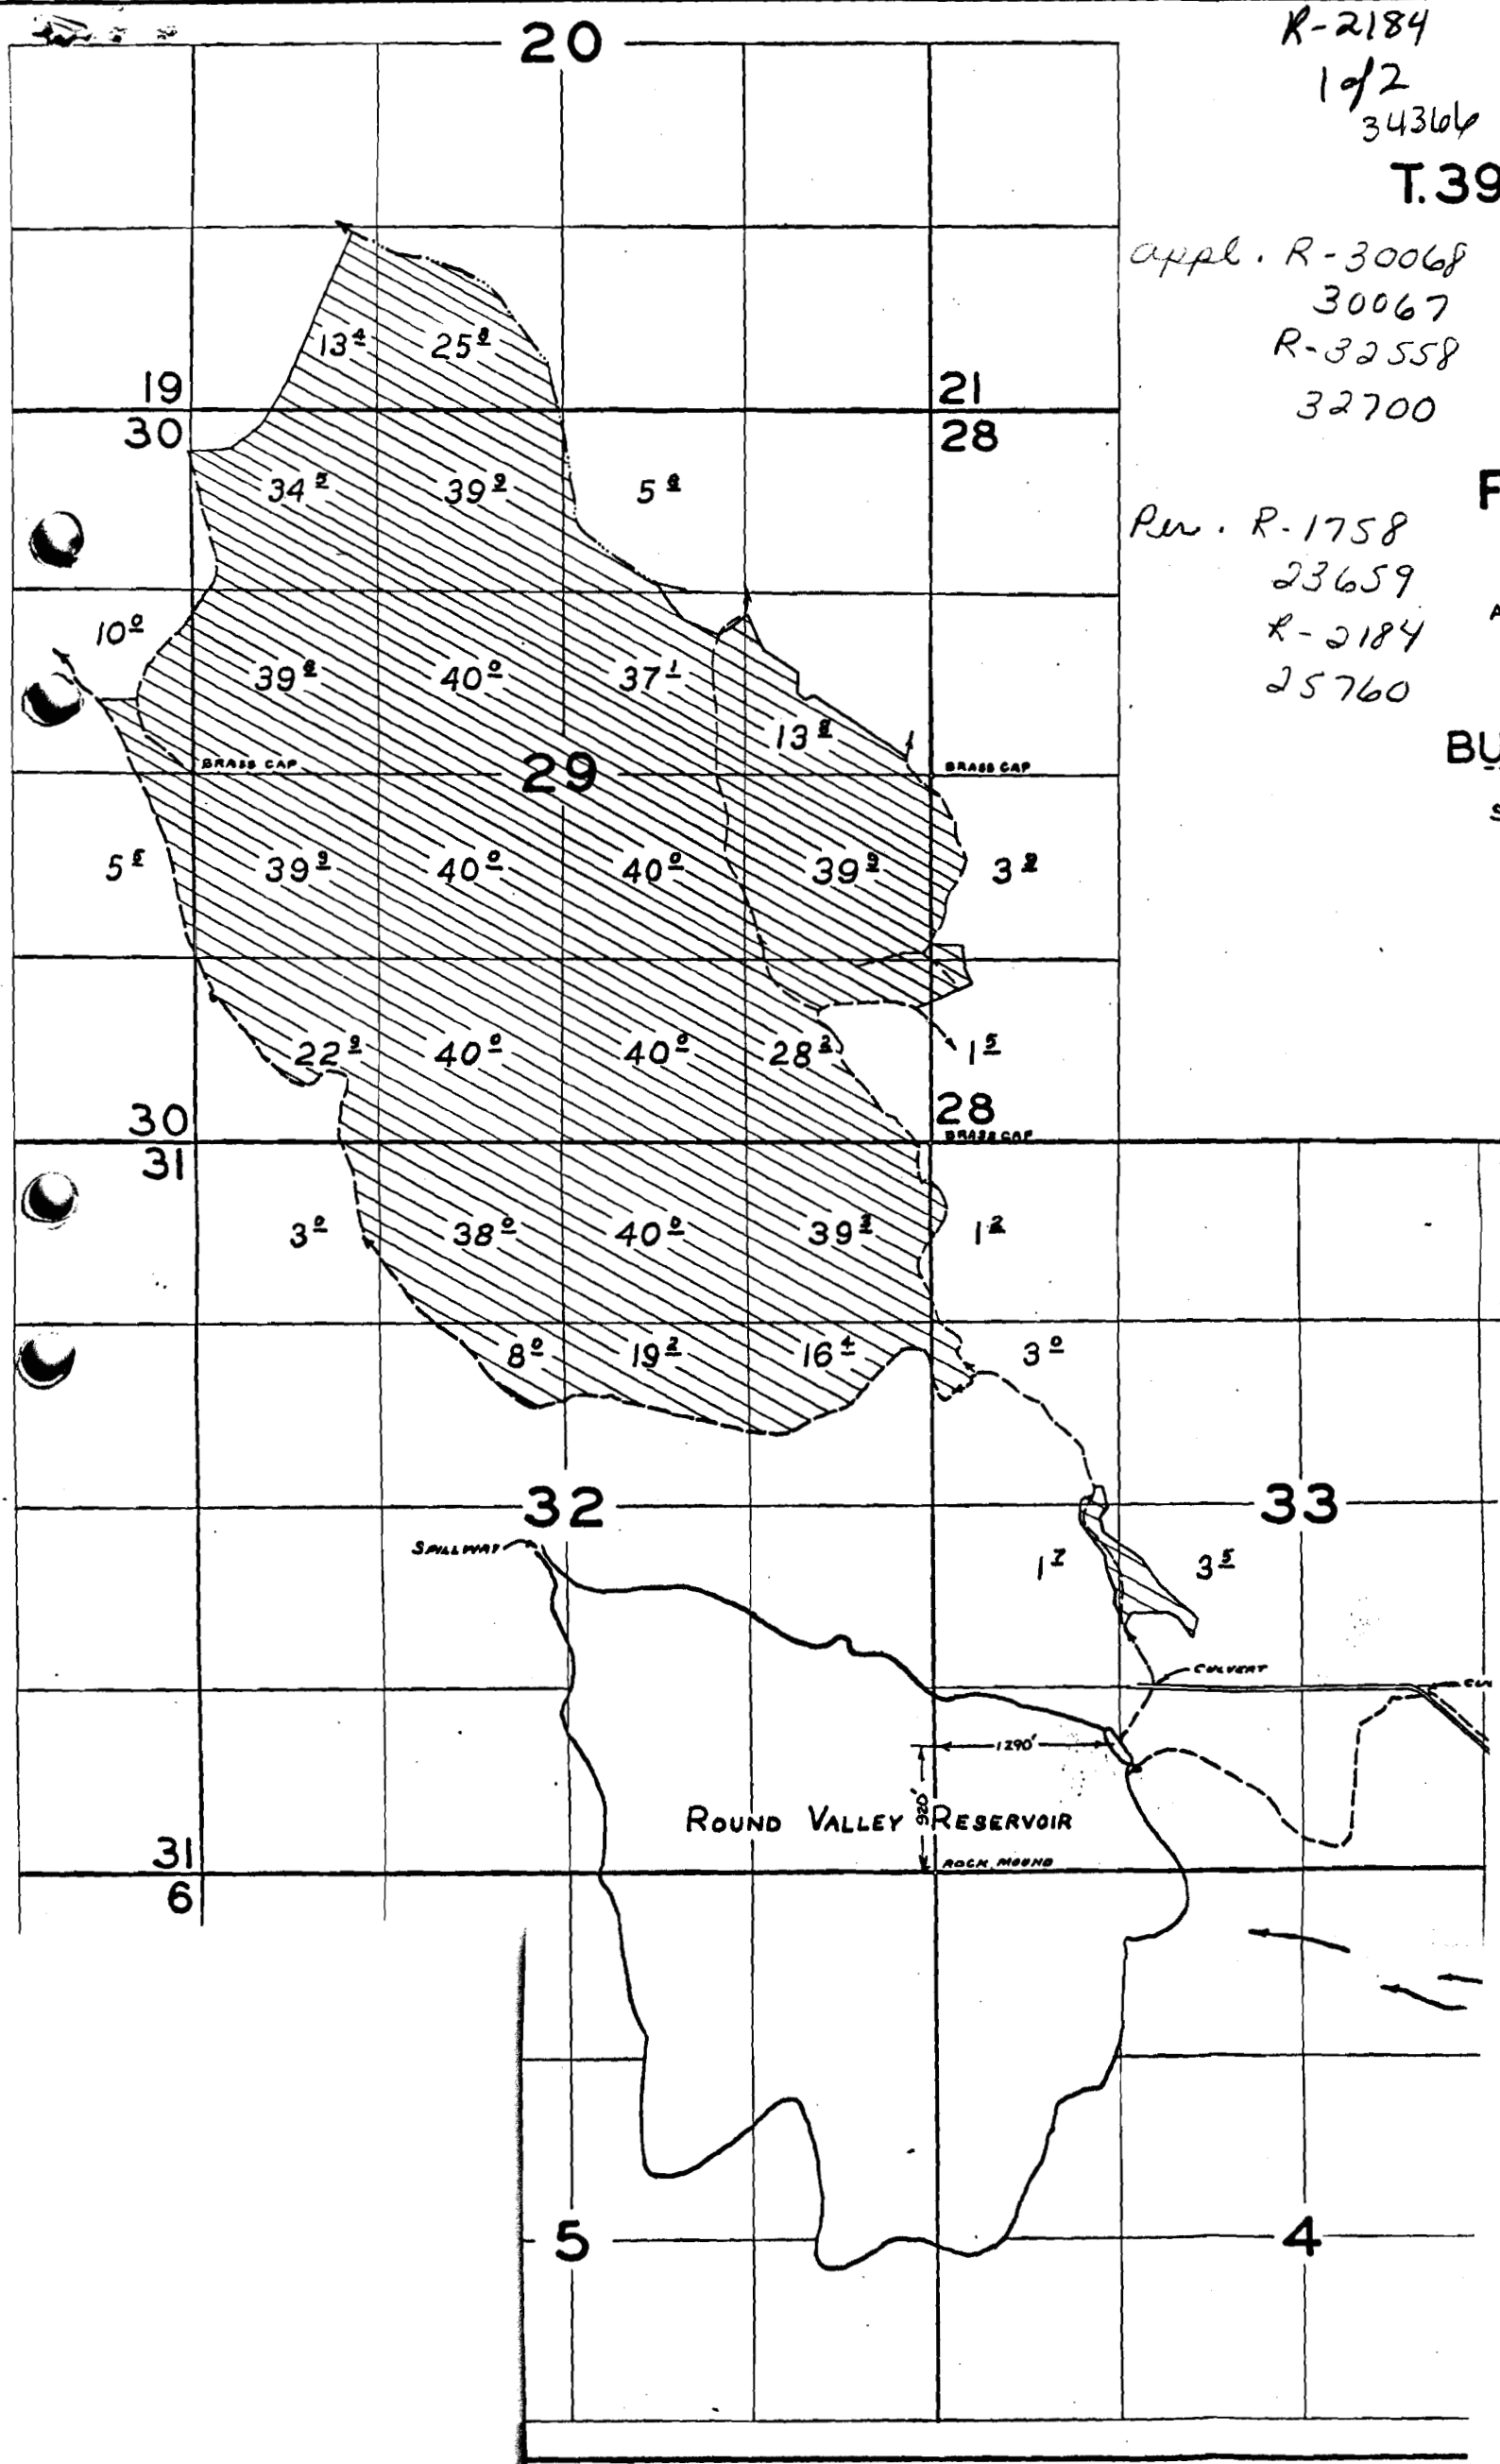

R-2184

1 of 2
34366

T.39

appl. R-30068
30067
R-32558
32700

Rev. R-1758
23659
R-2184
25760

F
A
BU
S

R-2184
242

T.39 & 40 S. R.14 & 14½ E. W.M.

FINAL PROOF SURVEY

UNDER

APPLICATION NO. 32700 PERMIT NO. 25760

IN NAME OF
U.S. DEPT. OF INTERIOR
BUREAU OF LAND MANAGEMENT

SURVEYED JUL. 24, 1964, BY R. JACKSON
Insp. June 20, 1967, BY V. Garner

21
28
32
28

