


T.16S.R.2E.W.M.

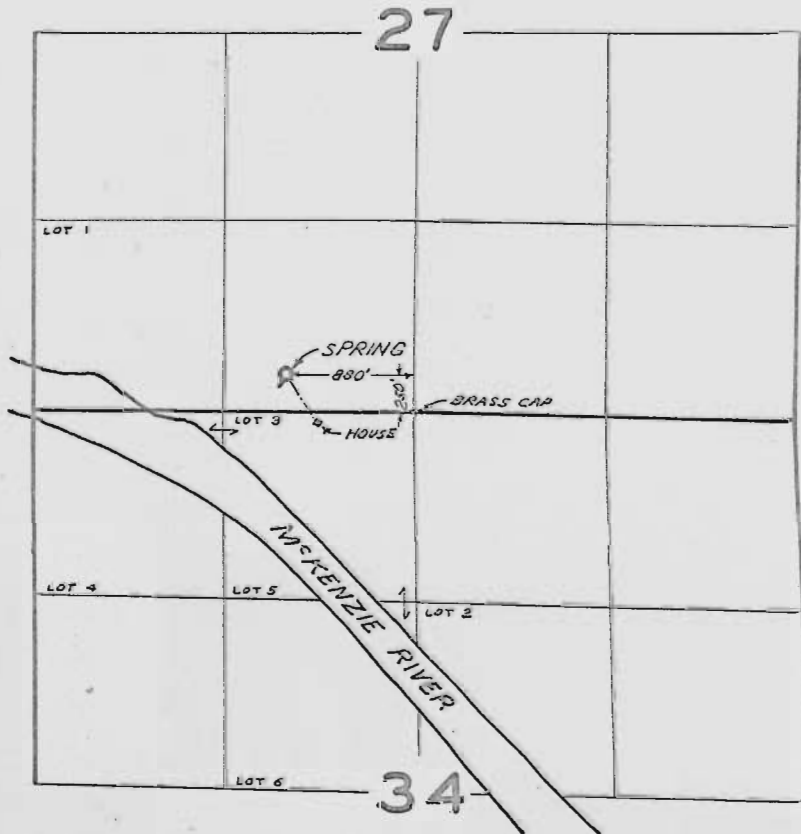

FINAL PROOF SURVEY
UNDER

Application No. 34749 Permit No. 27320
IN NAME OF

AUDIE T. DONOHO

Surveyed SEP. 2 1966, by L. GOULD