


T.17S.R.2E.W.M.

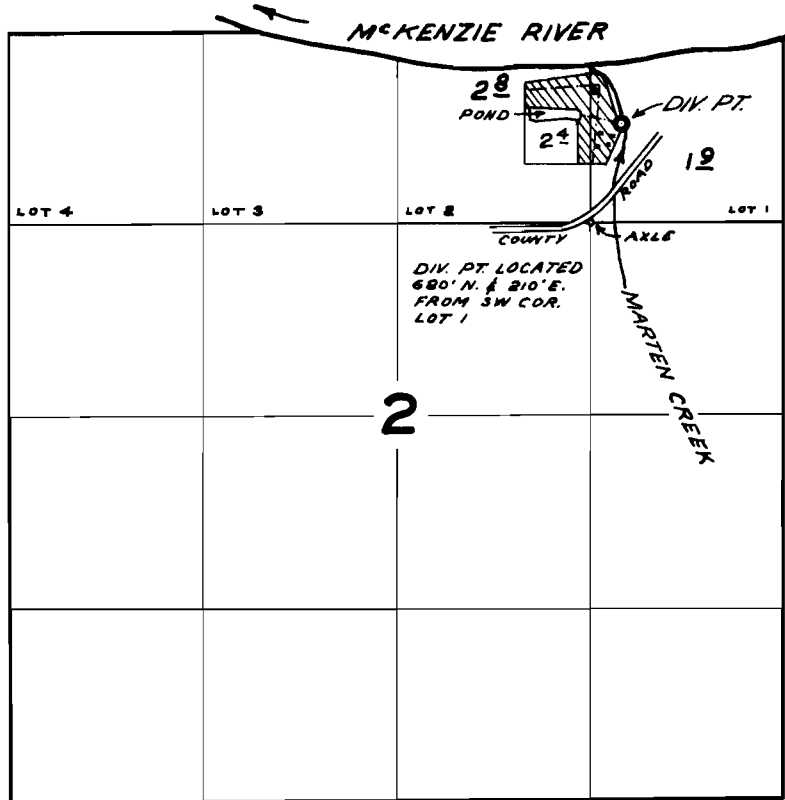

FINAL PROOF SURVEY UNDER

Application No. 34048 Permit No. 26842

IN NAME OF

WILLIAM M. & JEAN F. FARRER

Surveyed AUG. 31 1966, by L. GOULD