


T. 16 & 17 S. R. 2 E. W. M.

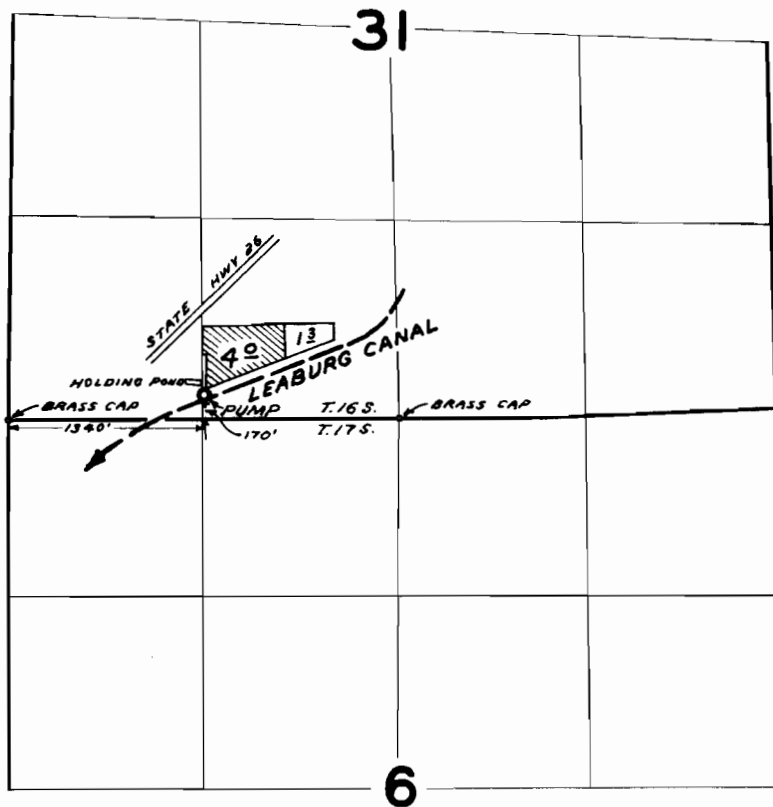

FINAL PROOF SURVEY
UNDER

Application No. 34005 Permit No. 26787
IN NAME OF

HENRY'S BLUEBERRY FARM

Surveyed Aug. 30 1966, by L. GOULD