


T.20 & 21 S. R. 4 W. W.M.

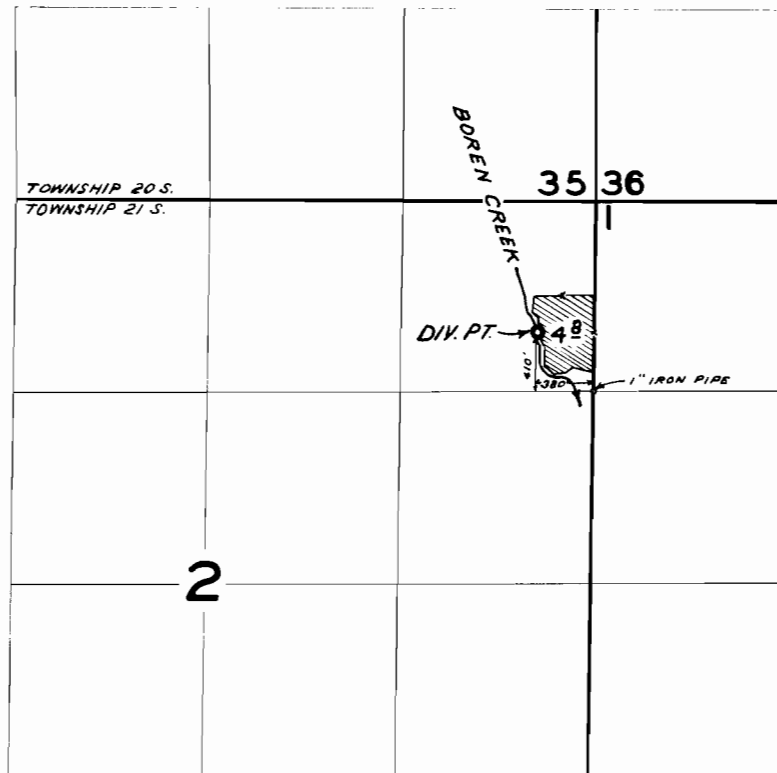

FINAL PROOF SURVEY
UNDER

Application No. 34270 Permit No. 26968
IN NAME OF

ARCHIE D. HILL

Surveyed MAY 13 1966, by L. GOULD