


T.20S.R.3W.W.M.

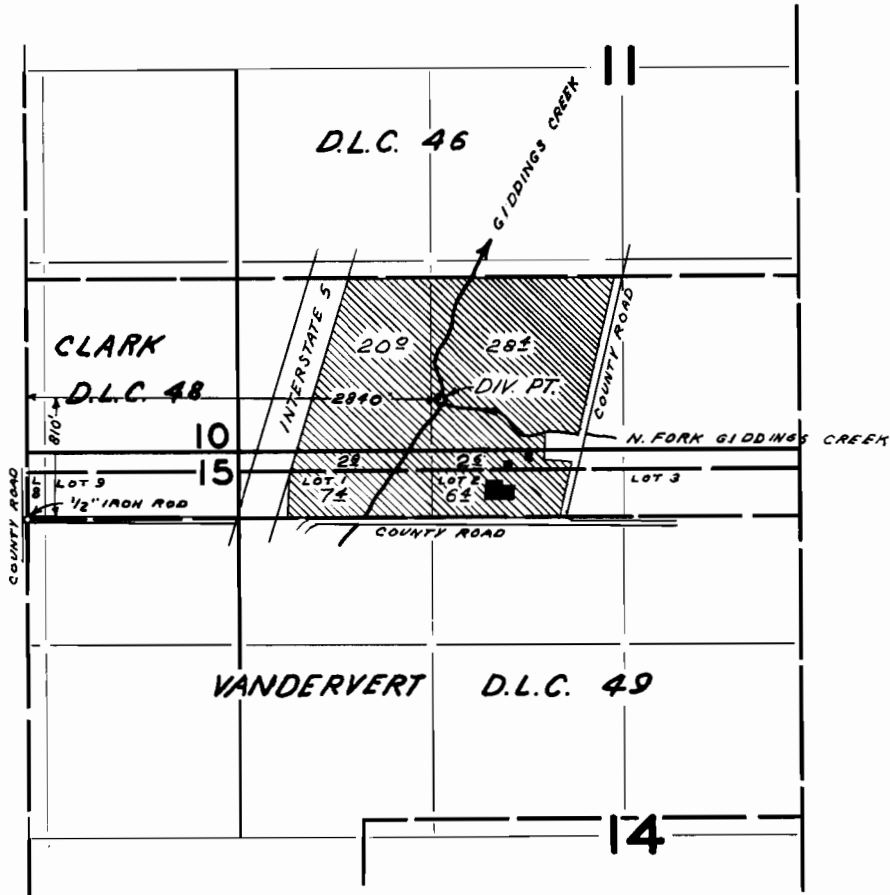

FINAL PROOF SURVEY
UNDER

Application No. 34989 Permit No. 27432
IN NAME OF

VEREL C. MORRELL

Surveyed MAY 11, 1966, by L. GOULD