


T.16 S. R.3W. W.M.

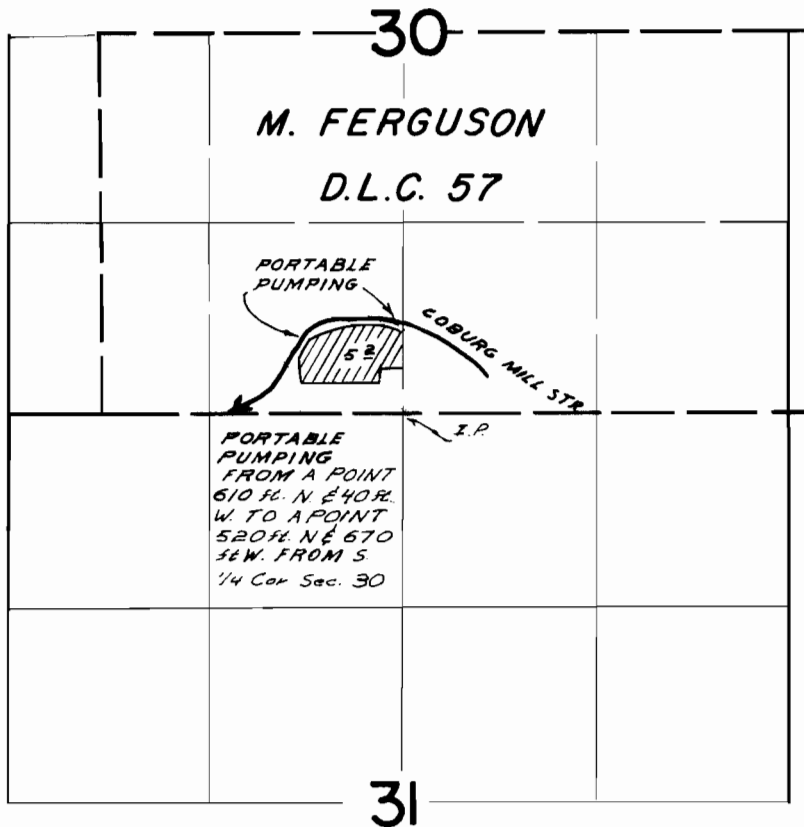

FINAL PROOF SURVEY
UNDER

Application No. 34693 Permit No. 27258

IN NAME OF

BEN SNYDER

Surveyed APR. 27 1965, by L. COLEBANK