


T.9S.R.1E.W.M

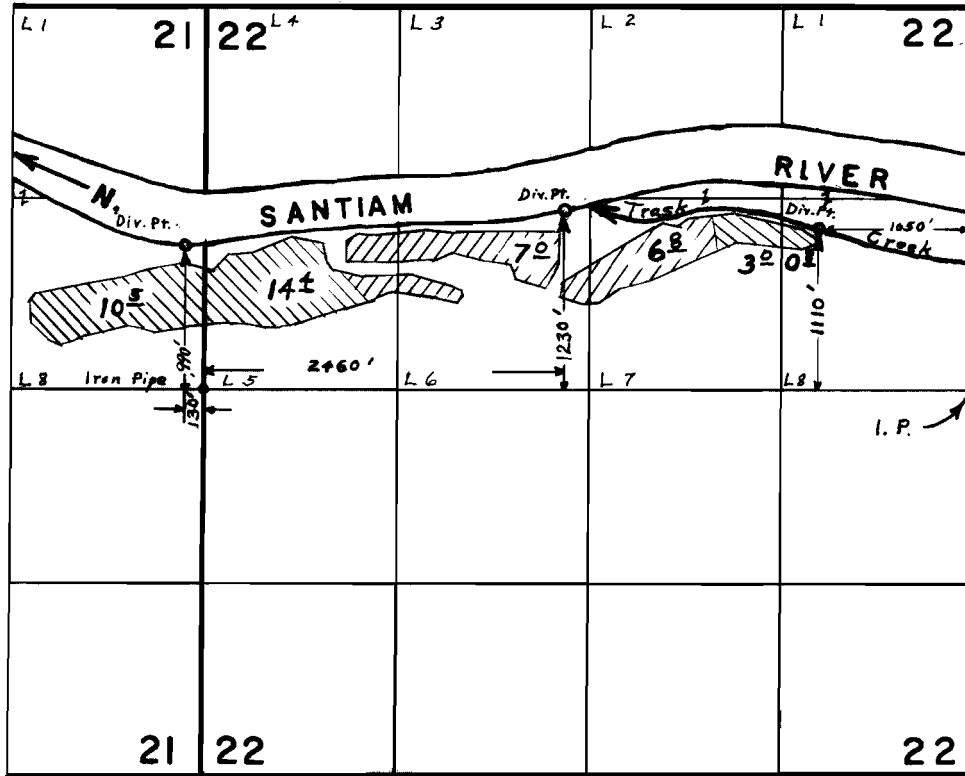

FINAL PROOF SURVEY UNDER

Application No. 32 074. Permit No. 256.15....
IN NAME OF

-----KORA.....P.RICHARD.....

Surveyed APRIL 27, 1966, by *L. E. Gould*