


T.10S.R2W.W.M.

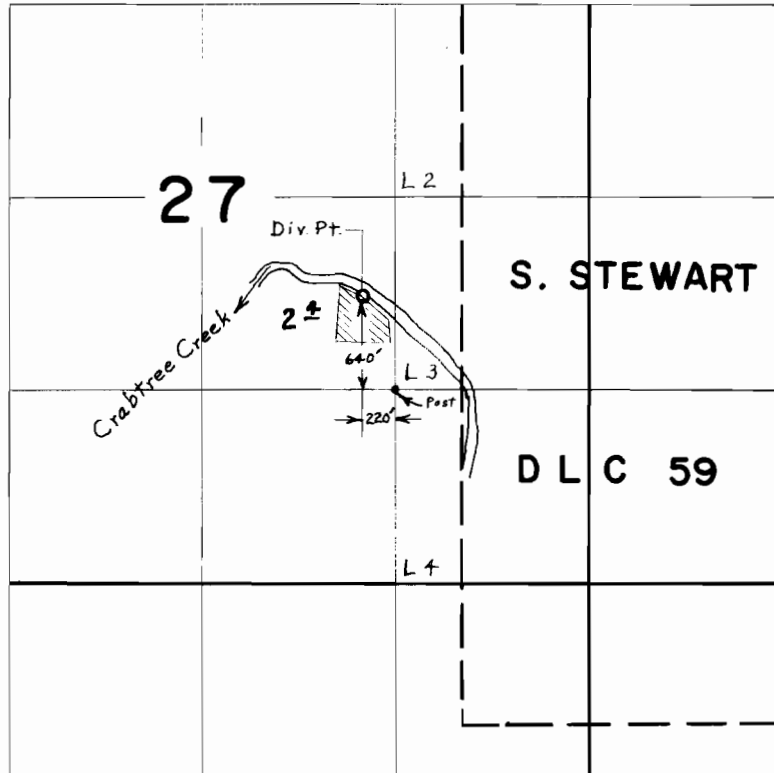

FINAL PROOF SURVEY UNDER

Application No. 34858 Permit No. 27359
IN NAME OF

JOHN R. SANDERS

Surveyed *April 28, 1966.* by *L. E. Gould*