


T.26S.R.46E.W.M.

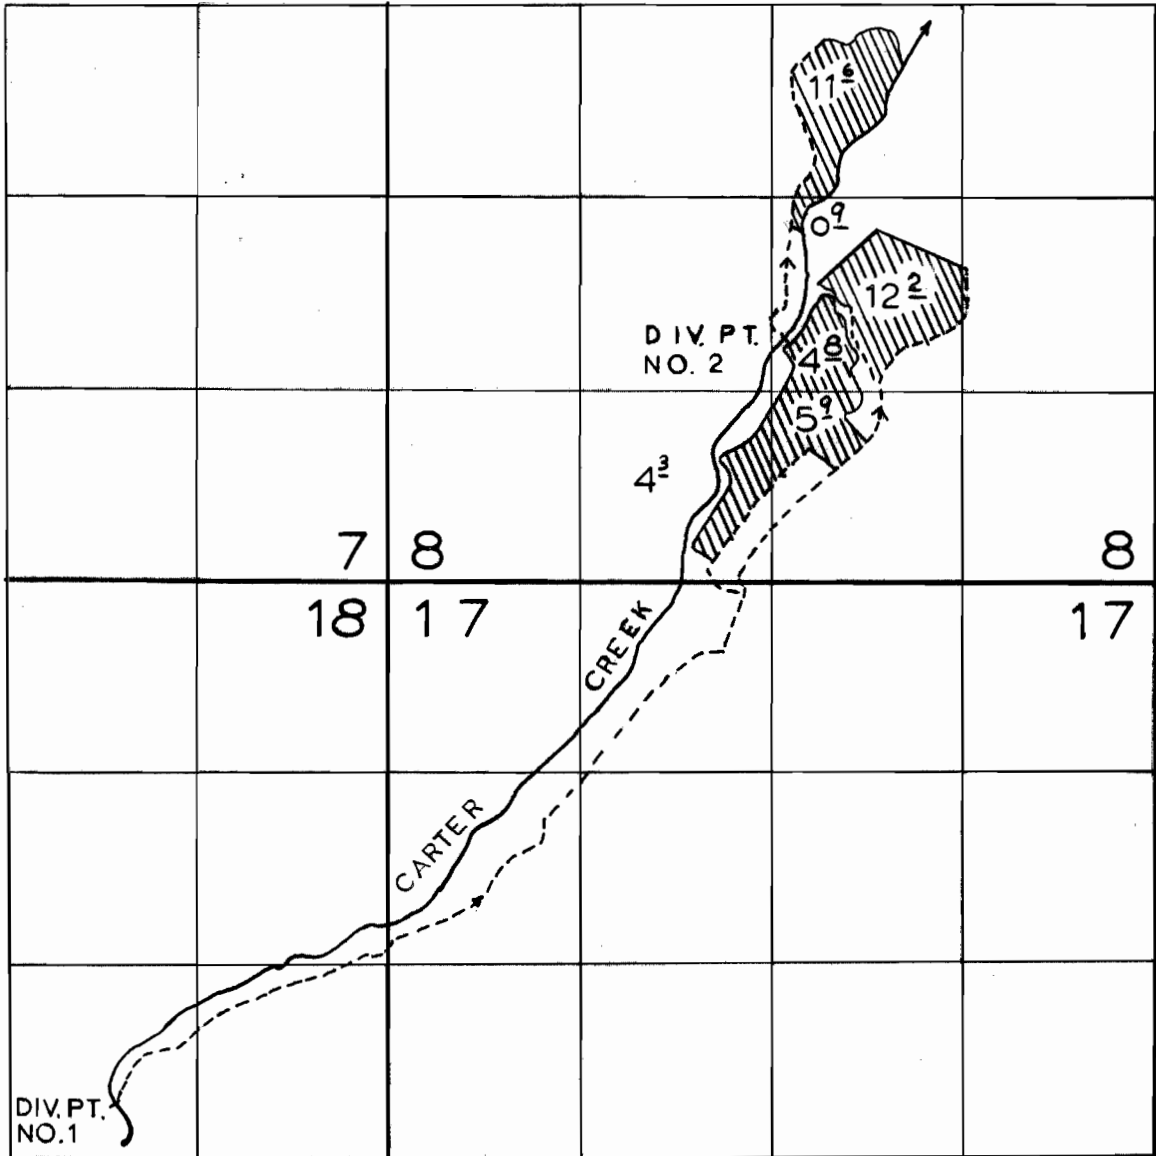

DIV. PT. NO.1 - 3580' S. & 1870' W. FROM NE. COR. SEC. 18
DIV. PT. NO.2 - 1675' N. & 2730' E. FROM SW. COR. SEC. 8

FINAL PROOF SURVEY
UNDER

Application No. 37531 Permit No. 27970
IN NAME OF
MAUDE H. GREELEY
Surveyed MARCH 4 1966, by F. ELFERING