


T.8S.R.3W.W.M.

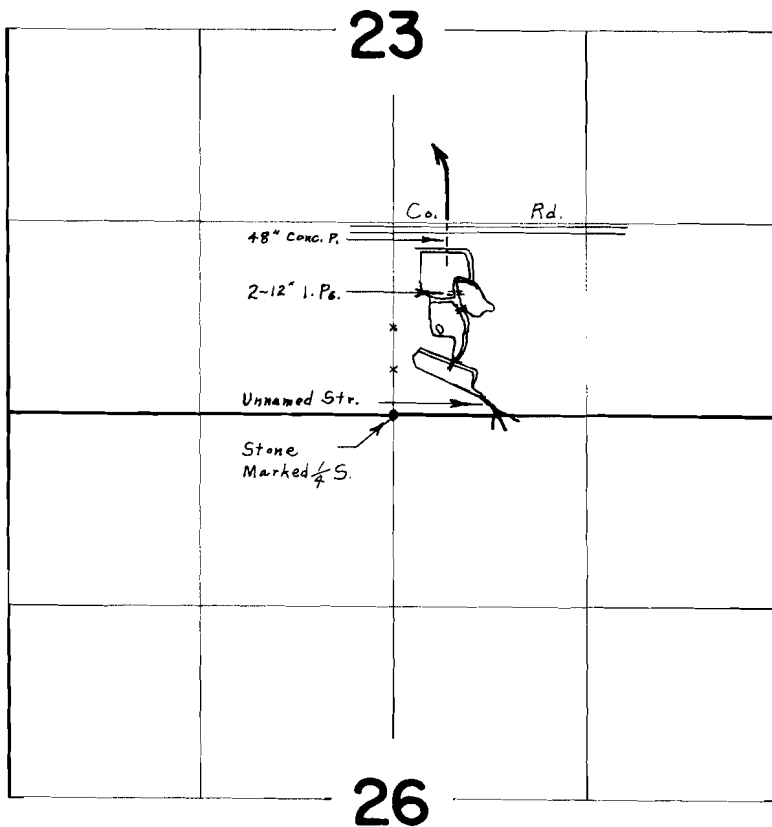

FINAL PROOF SURVEY UNDER

Application No. ~~R-41454~~ Permit No. ~~R-4689~~
IN NAME OF

CENTURY REALTY CORPORATION

Surveyed Sept. 7, 1966, by *R. E. Gould*