


T.8S.R.3W.W.M.

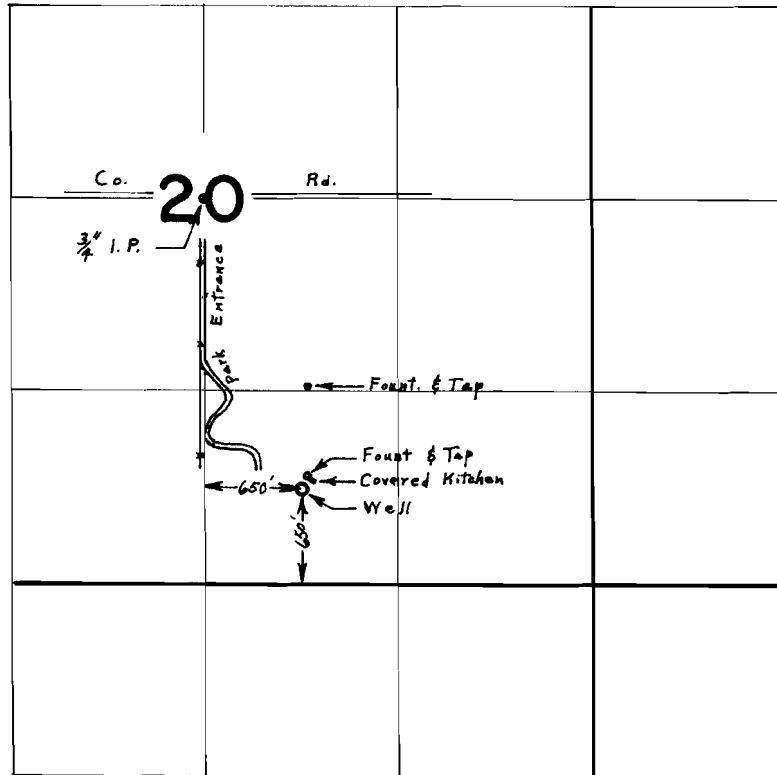

FINAL PROOF SURVEY UNDER

Application No. G-3056 Permit No. G-2852
IN NAME OF

MARION COUNTY PARK & RECREATION COMMISSION

Surveyed Sept. 7, 1966, by L. E. Gould