


T.2S.R.25E.W.M.

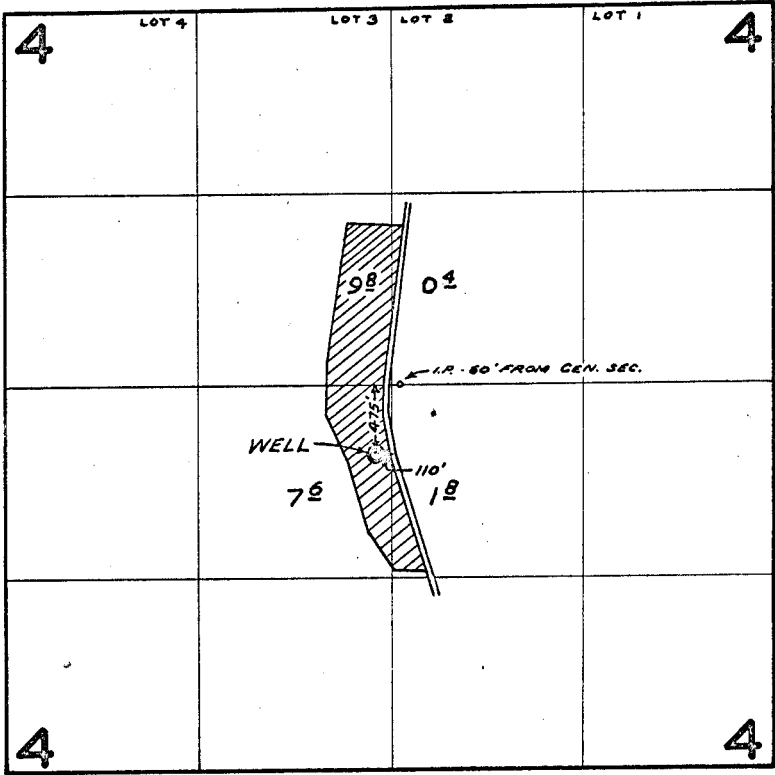

FINAL PROOF SURVEY UNDER

Application No. G-1898 Permit No. G-1739
IN NAME OF
EMMA P. PECK

Surveyed Jul. 1, 1966, by L. Gould