


T.4N.R.28E.W.M.

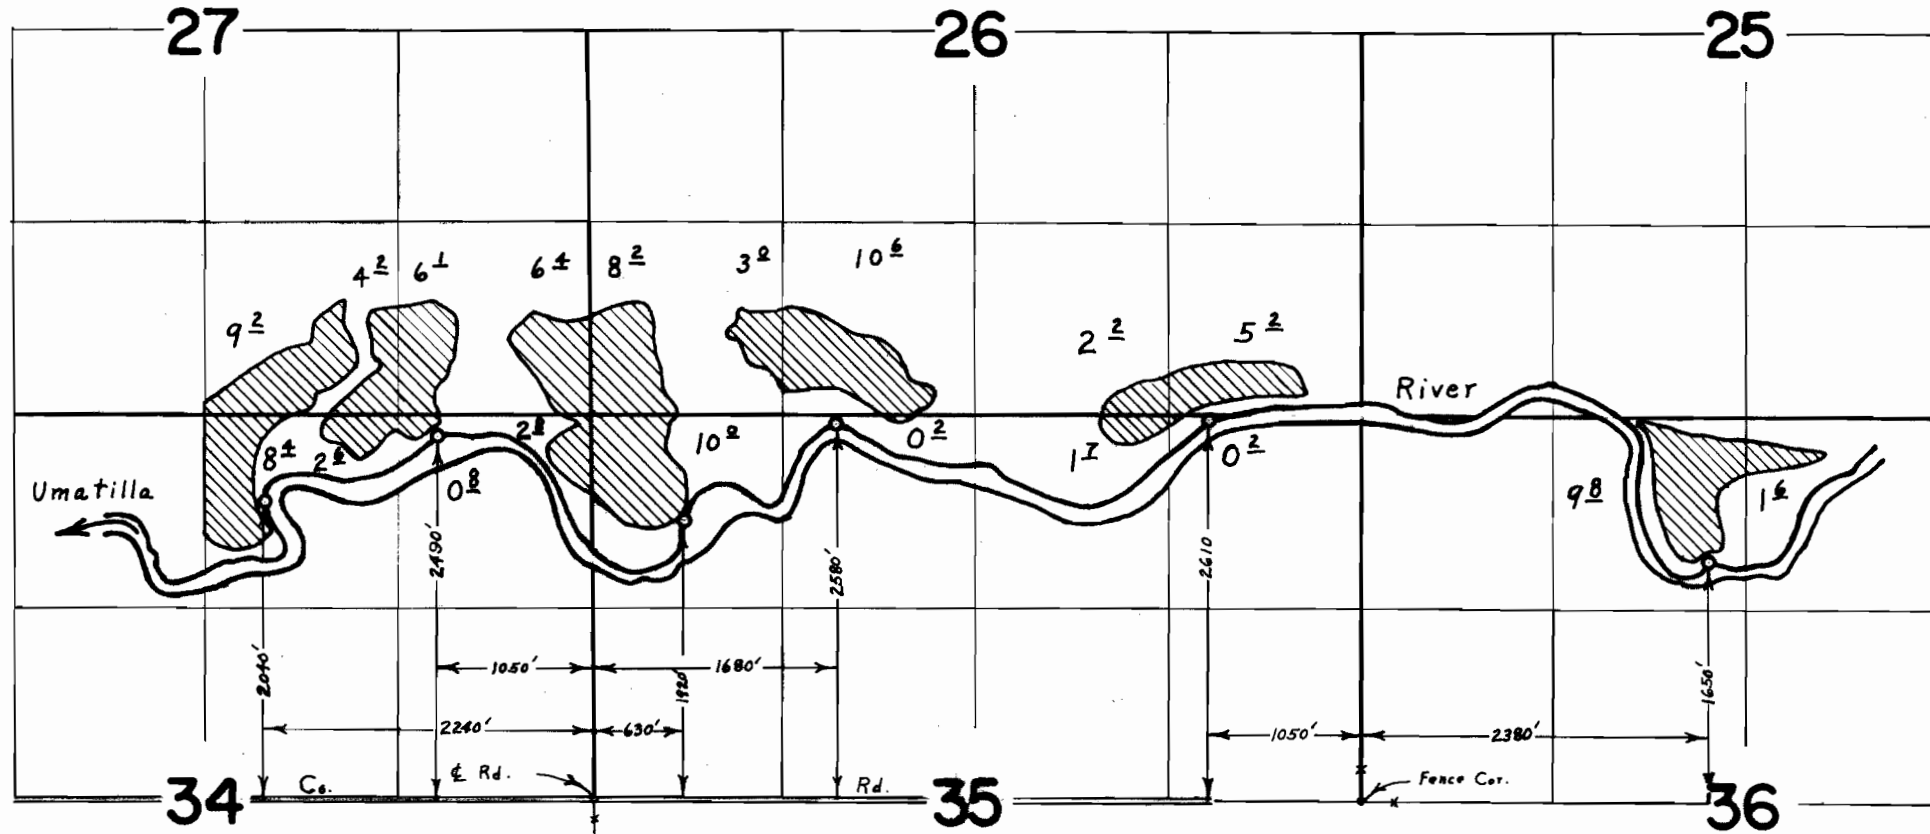

FINAL PROOF SURVEY
UNDER

Application No. 40333 Permit No. 30078
IN NAME OF

IRVIN MANN JR.

Surveyed August 6 1966 by L. E. Gould