


T.4N.R28E. W.M.

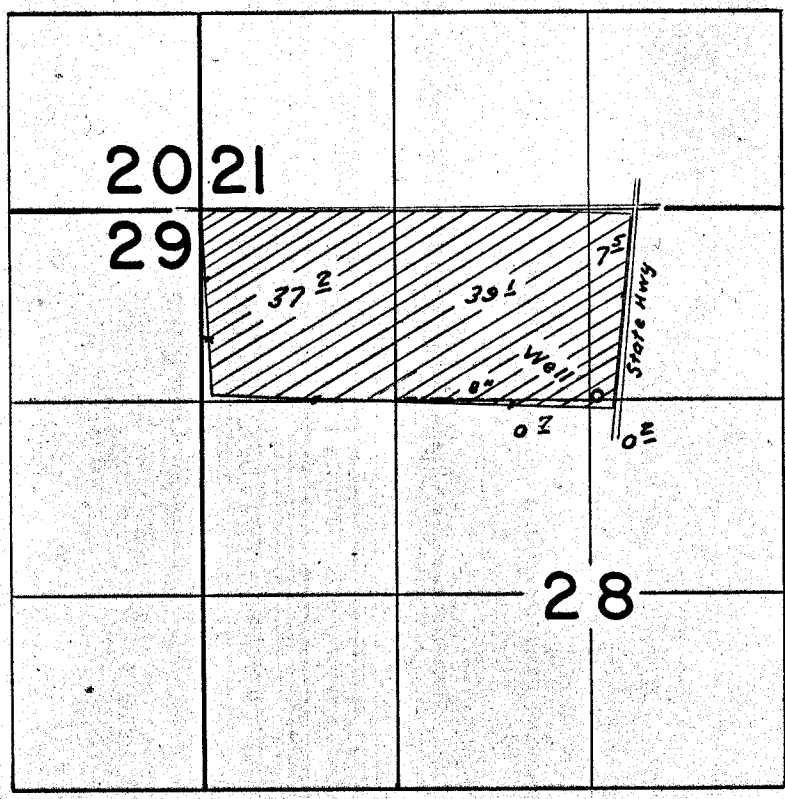

FINAL PROOF SURVEY UNDER

Application No. G-1824 Permit No. G-1675
IN NAME OF
WILLIAM T. TURNER

Surveyed April 14, 1964, by R. Jackson
June 26 1967 by L. E. Gould