


7
G-2221
34392

T.4N.R.29E.W.M.

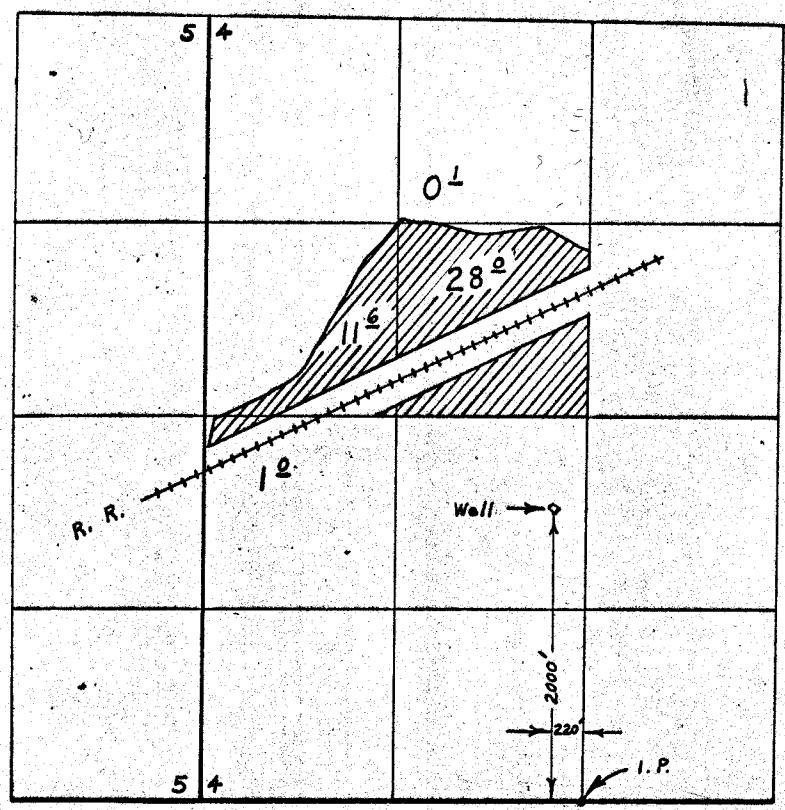

FINAL PROOF SURVEY UNDER

Application No. G-1686. Permit No. G-2221.
IN NAME OF
JOHN F. WALCHLI

Surveyed Aug. 11, 1966, by L. E. Gould