


T.2 S.R.39 E.W.M.

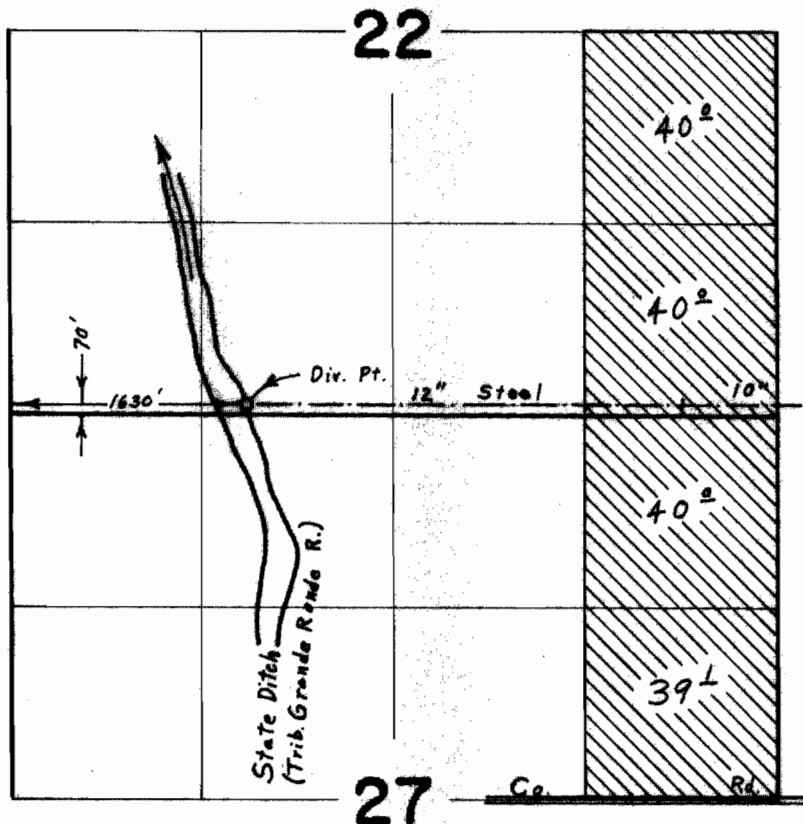

FINAL PROOF SURVEY
UNDER

Application No. 37058 Permit No. 27572
IN NAME OF

WILLIAM D. & LILLIE B. MILLER

Surveyed Nov. 1 1966, by L. E. Gauld