


T.2S.R.39E.W.M.

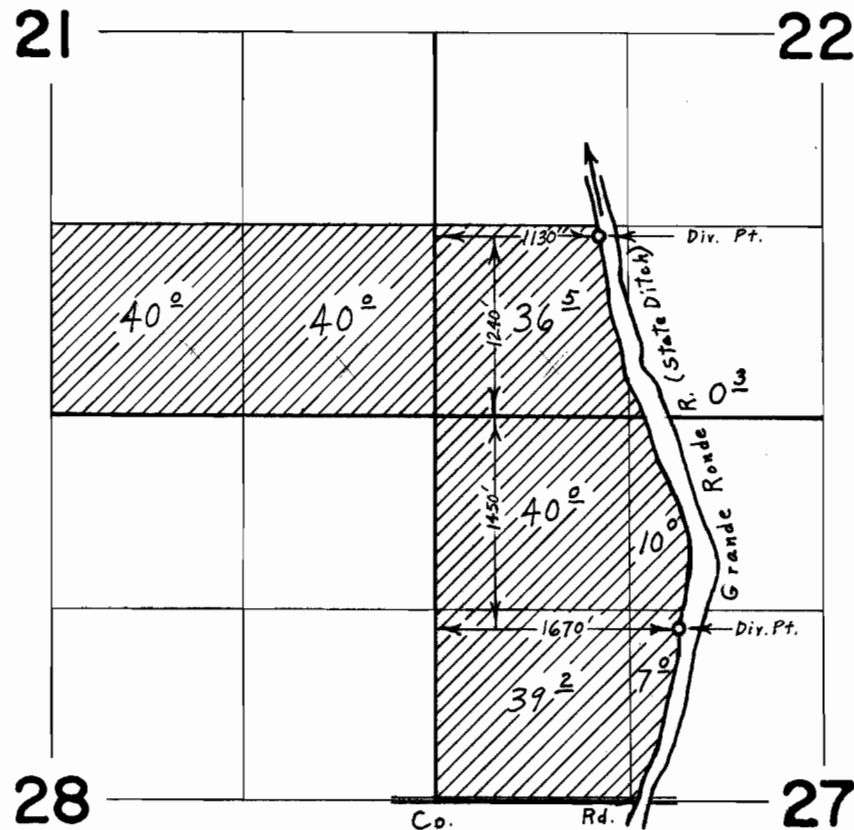

FINAL PROOF SURVEY
UNDER

Application No. 38162 Permit No. 28448
IN NAME OF

SYLVAN B. & MARTHA JOY RASMUSSEN

Surveyed Nov. 1 1966, by L. E. Gould