


T.3S.R.45 E.W.M.

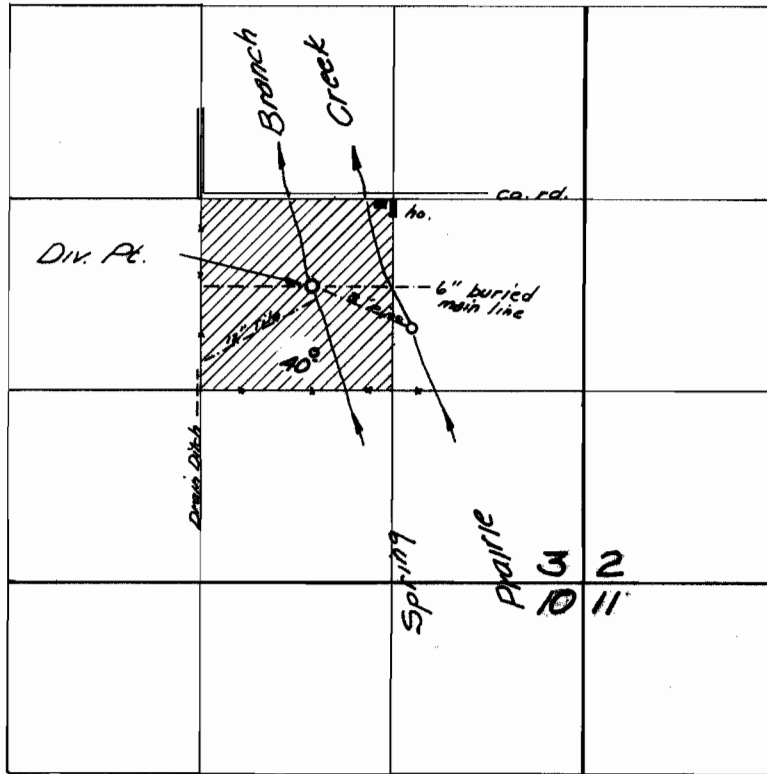

Div. Pt. located 600 ft. S. of 770 ft. E. from the center of Section 3

FINAL PROOF SURVEY UNDER

Application No. 37816 Permit No. 28280
IN NAME OF

IDA G. ESTES

Surveyed June 22 1966, by V. GARNER