


# T.2S.R.45E.W.M.

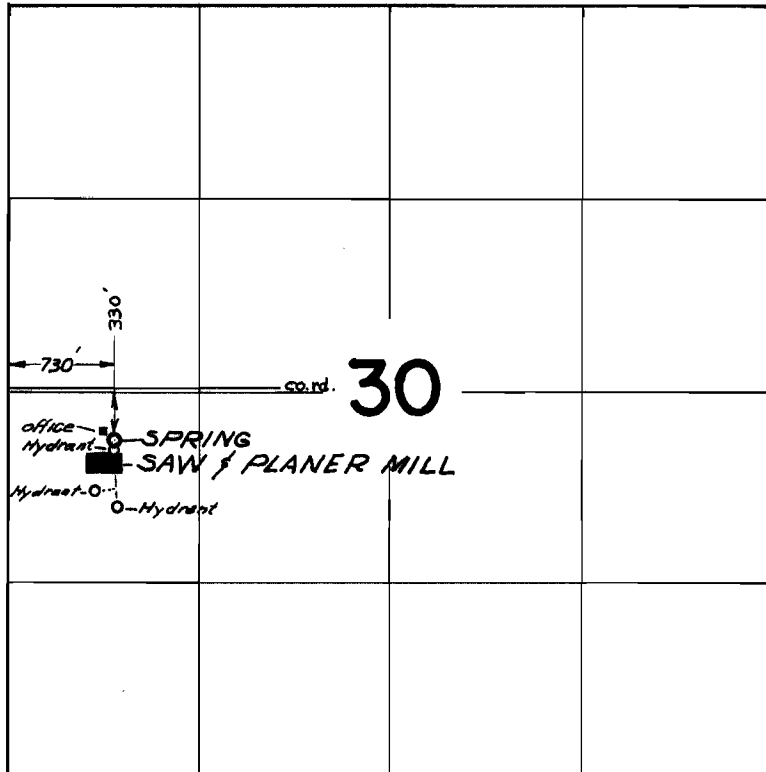

## FINAL PROOF SURVEY UNDER

Application No. 37553 Permit No. 27982  
IN NAME OF

CHIEF JOSEPH LUMBER COMPANY

Surveyed June 28 1966, by V. GARNER