


T. 2 S. R. 44 E. W.M.

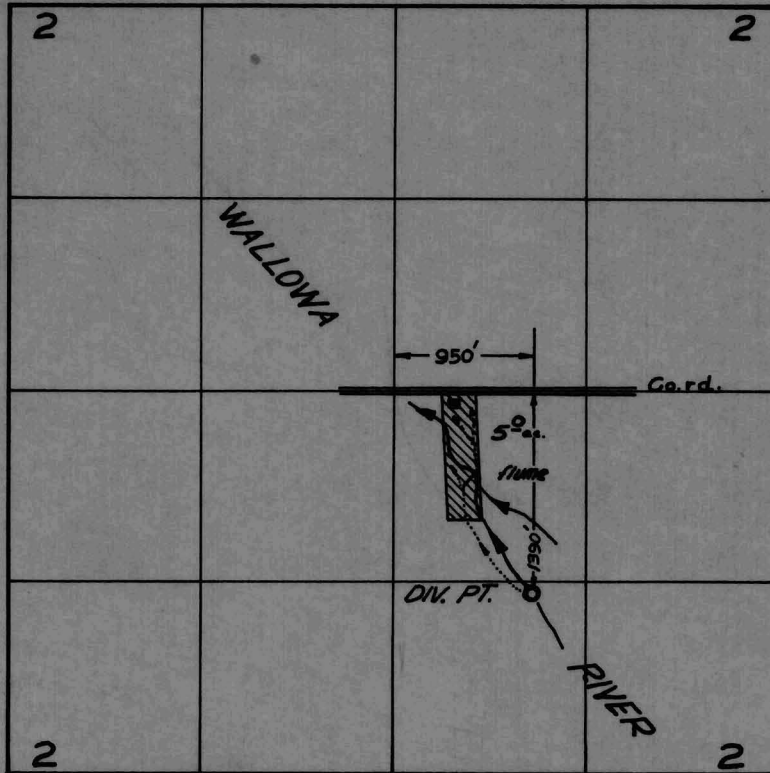

LAYOUT
WRONG

FINAL PROOF SURVEY UNDER

Application No. 33432 Permit No. 26430
IN NAME OF

JAKE and ETHEL MARKS

Surveyed June 25 1966, by V. GARNER