


# T. 2 S. R. 44 E. W.M.

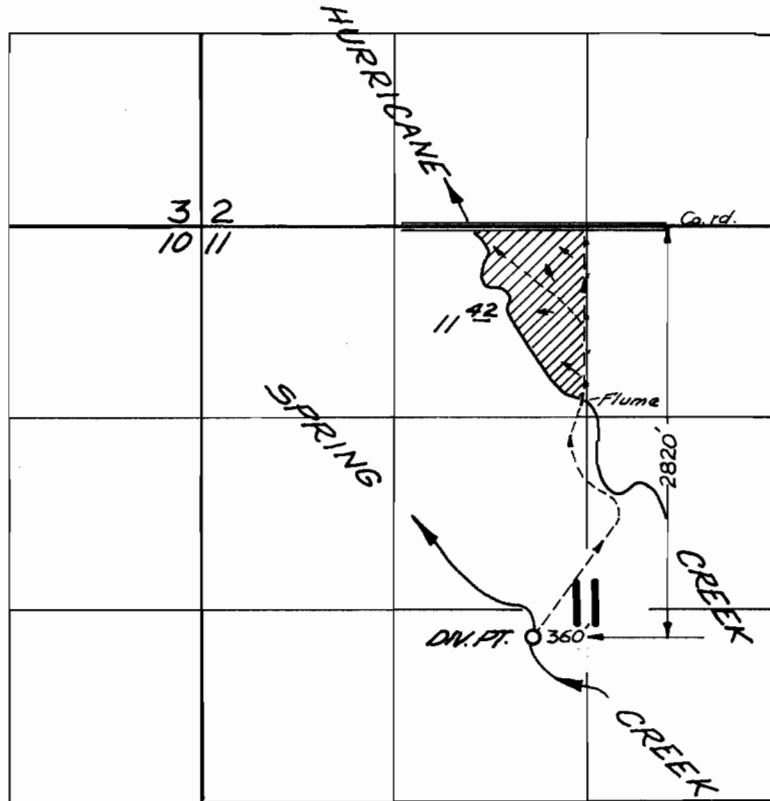

## FINAL PROOF SURVEY UNDER

Application No. 40458 Permit No. 30157  
IN NAME OF

LEON and LORAE MAWHIN

Surveyed June 27 1966, by V. GARNER