


T.1 N.R.43 E.W.M.

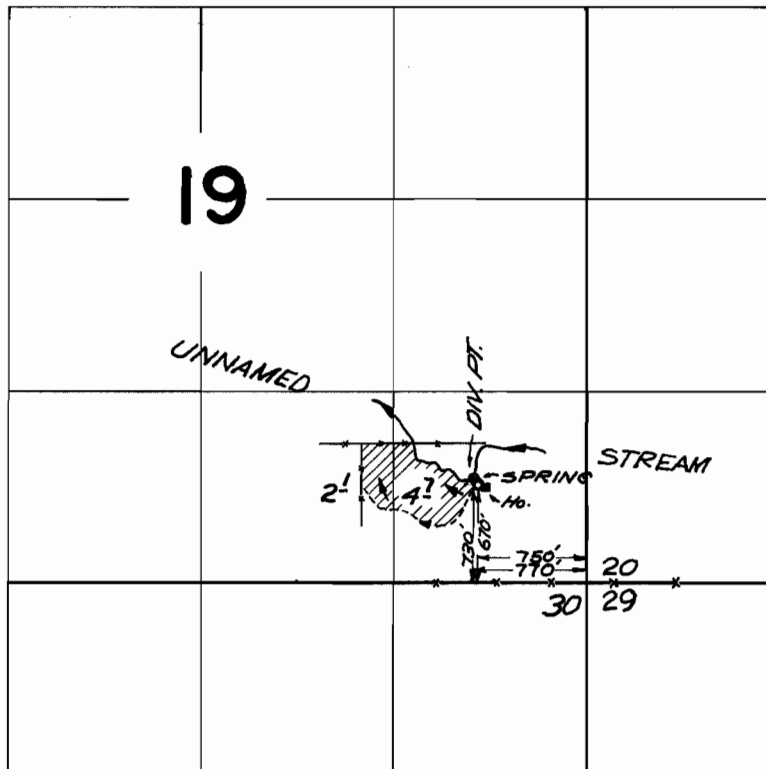

FINAL PROOF SURVEY UNDER

Application No. 32876 Permit No. 25966
IN NAME OF

FRANK and GERTRUDE RENFROW

Surveyed June 23 19.66, by V. GARNER