T. 34 S. R. 1 W. W. M.

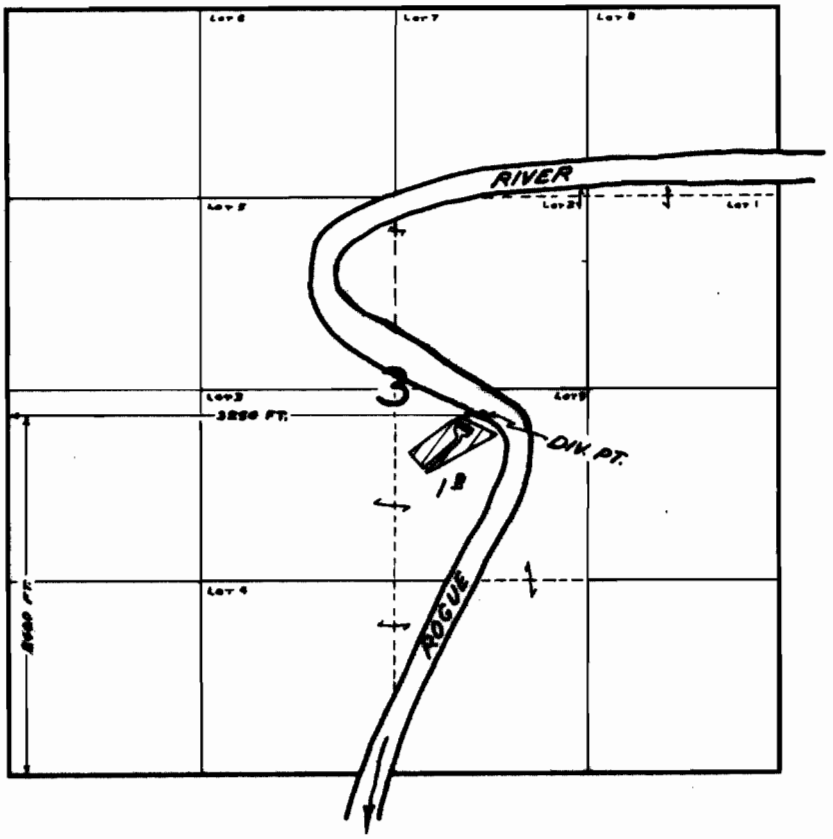

FINAL PROOF SURVEY
UNDER

Application No. 34291 Permit No. 26979
IN NAME OF

HAROLD F. JEWETT AND PAULINE H. JEWETT

Surveyed JUL. 15 1965, by C. GARDNER