


T.8S. R.40E.W.M.

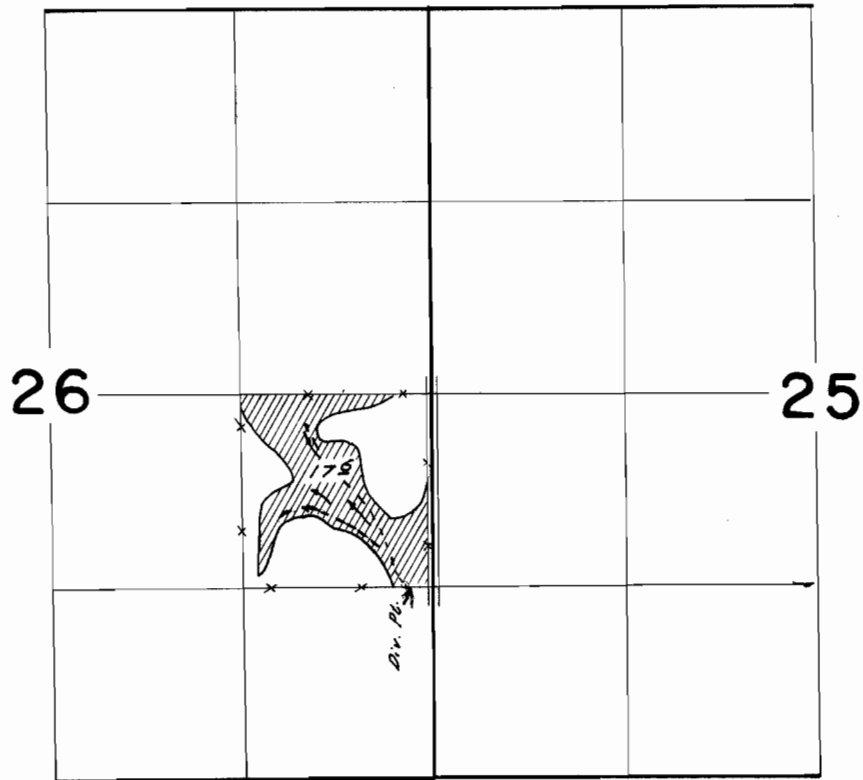

Div. Pt. located 170 ft. W. from NE/4 SE/4 Sec. 26

SE Corner of

FINAL PROOF SURVEY
UNDER

Application No. 37615 Permit No. 28173
IN NAME OF

Donald William Christy

Surveyed Aug. 8 1966, by W. J. Ruppel