


T. 7S. R. 38E. W.M.

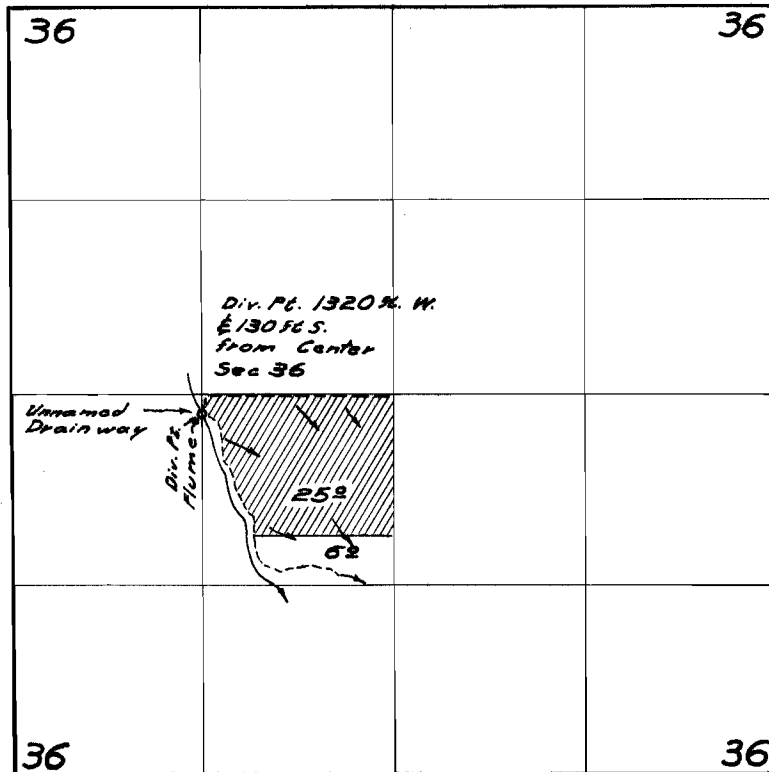

FINAL PROOF SURVEY
UNDER

Application No. 38311 Permit No. 28526
IN NAME OF

Donald William Christy

Surveyed Aug 6 1966, by W.D. Ruppert