


T. 9 S. R. 40 E. W. M.

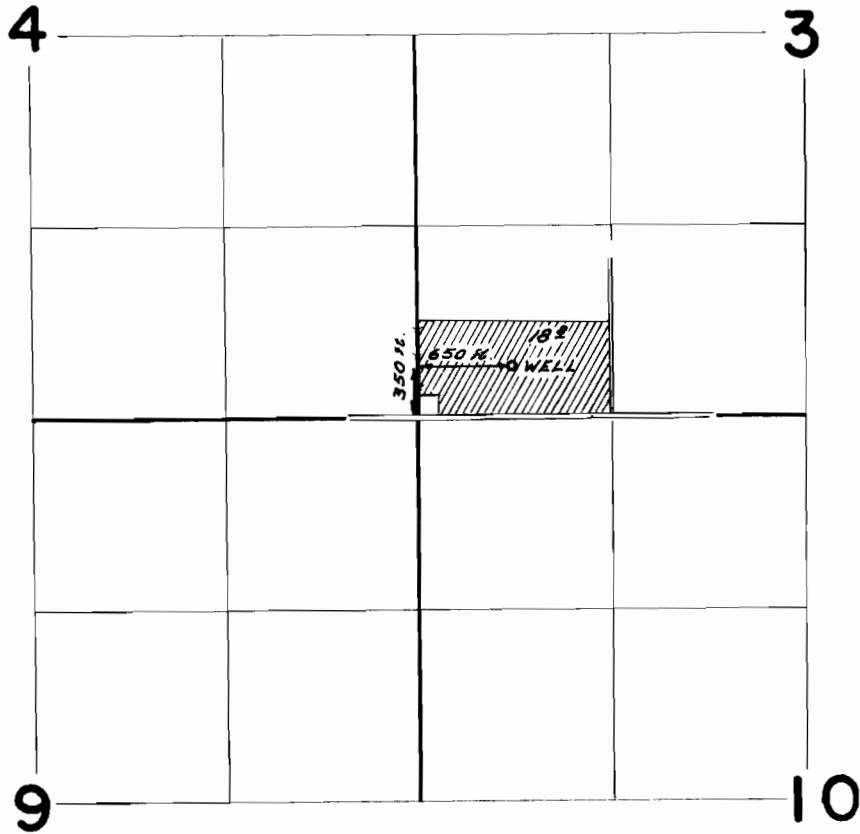

FINAL PROOF SURVEY
UNDER

Application No. G-3143 Permit No. G-2960
IN NAME OF

John C. Leonard

Surveyed Aug. 11, 1960, by W. J. Ruppert