


T.9S. R.40E.W.M.

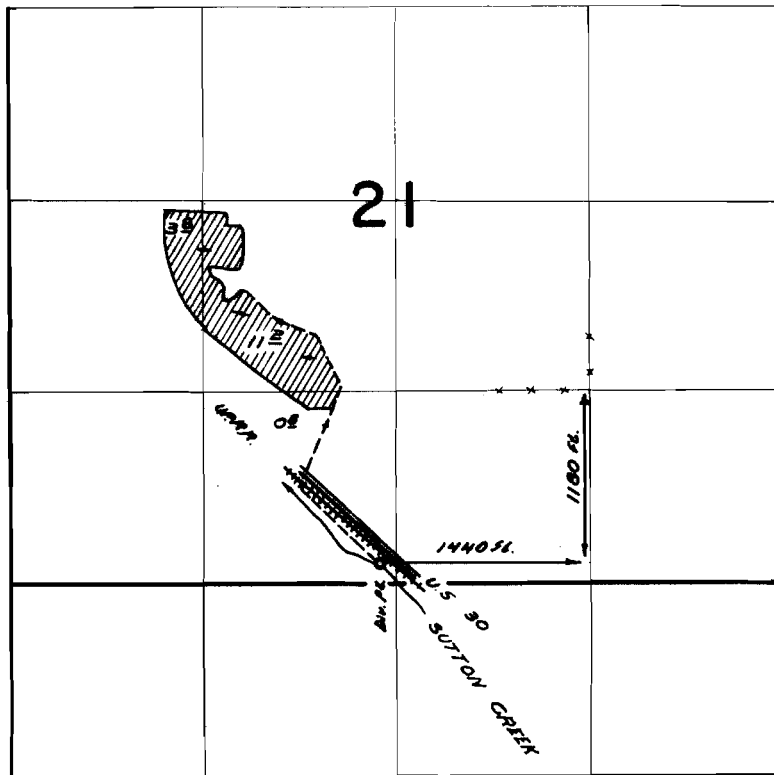

FINAL PROOF SURVEY
UNDER

Application No. 40629 Permit No. 30275
IN NAME OF

Andrew McKinney

Surveyed Aug 11, 1966, by W. J. Ruppert