


T.8S.R.39E.W.M.

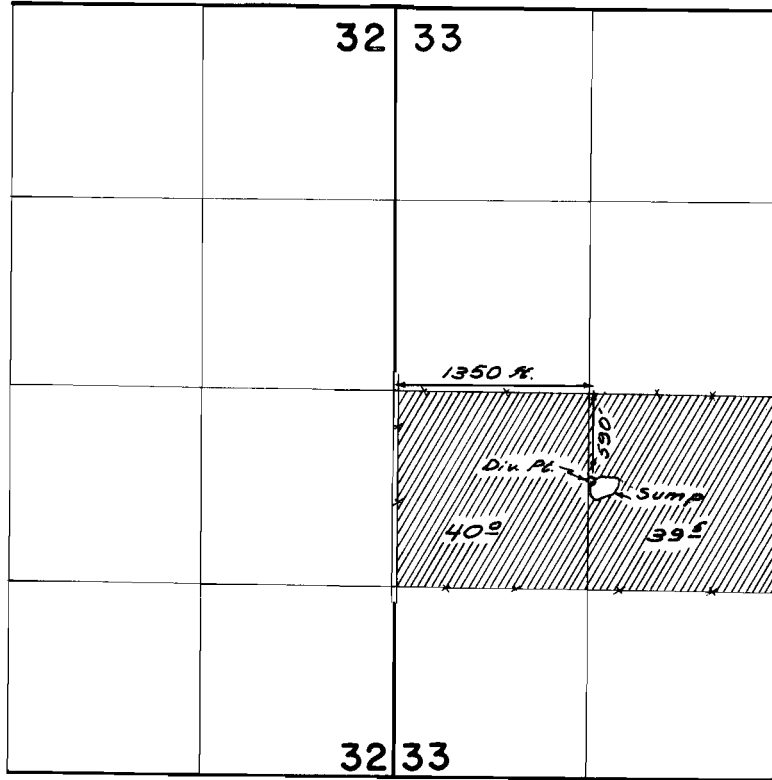

FINAL PROOF SURVEY
UNDER

Application No. G-2758 Permit No. G-2563
IN NAME OF

R. C. Marshall

Surveyed Aug. 2, 1966, by W. V. Ruppert.