


T. 7 S. R. 45 E. W.M.

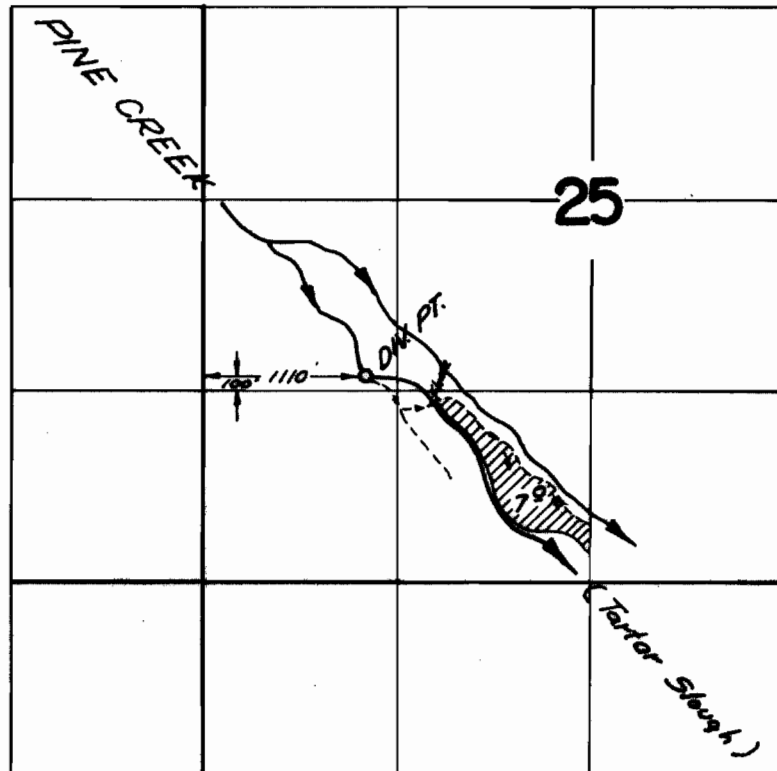

FINAL PROOF SURVEY
UNDER

Application No. 41202 Permit No. 30809
IN NAME OF

H. W. PRITCHARD

Surveyed Aug 6, 1966, by V. GARNER