


T.9S. R.39E. W.M.

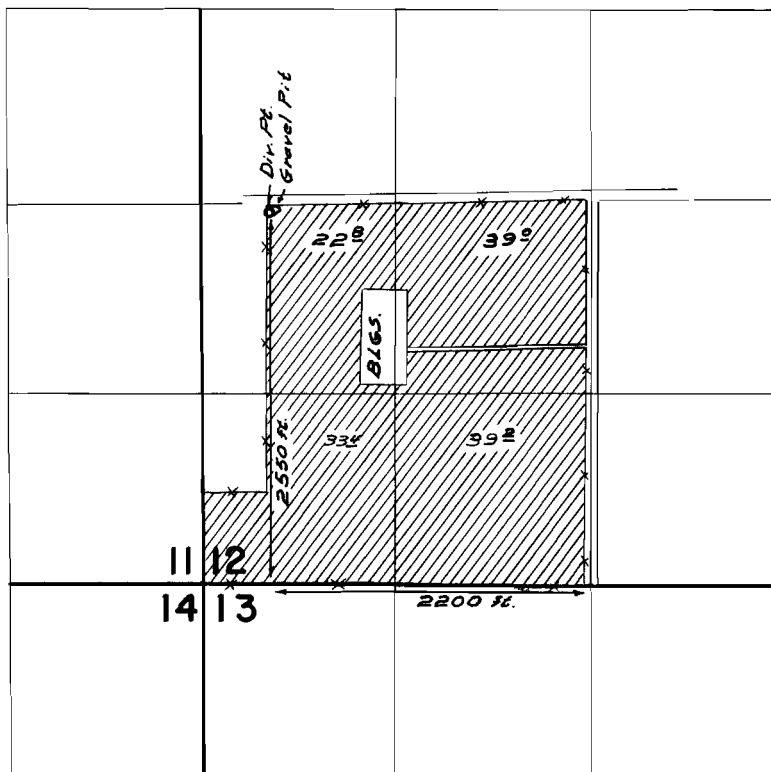

FINAL PROOF SURVEY
UNDER

Application No. G-2054 Permit No. G-1886
IN NAME OF

Park E. Taylor

Surveyed Aug. 9 1956, by W. J. August