


T.7 S. R.45 E.W.M.

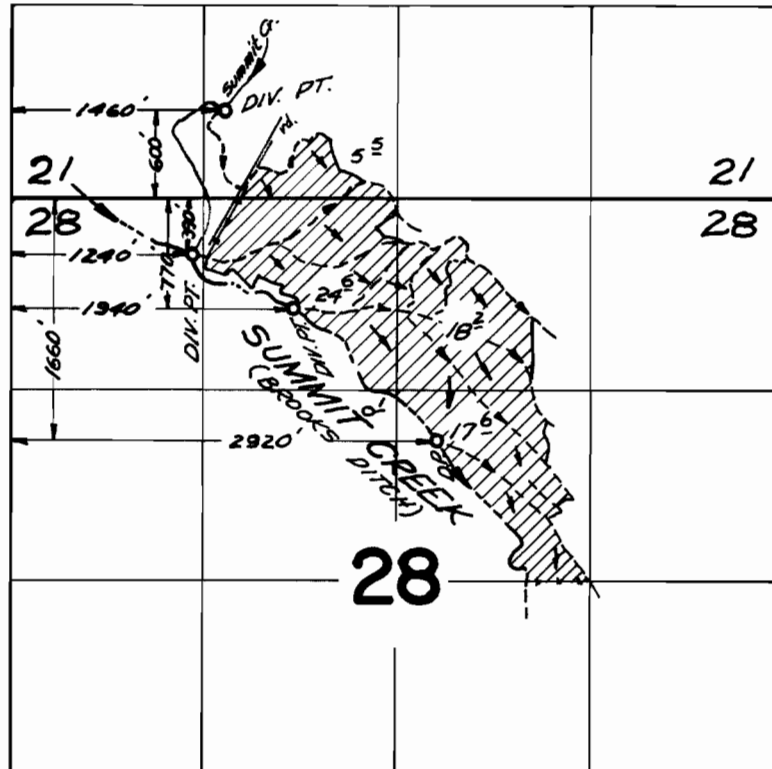

FINAL PROOF SURVEY
UNDER

Application No. 30601 Permit No. 24305
IN NAME OF

ROBERT D. THOMPSON

Surveyed Aug. 9, 1966, by V. GARNER