


T6S R44E WM

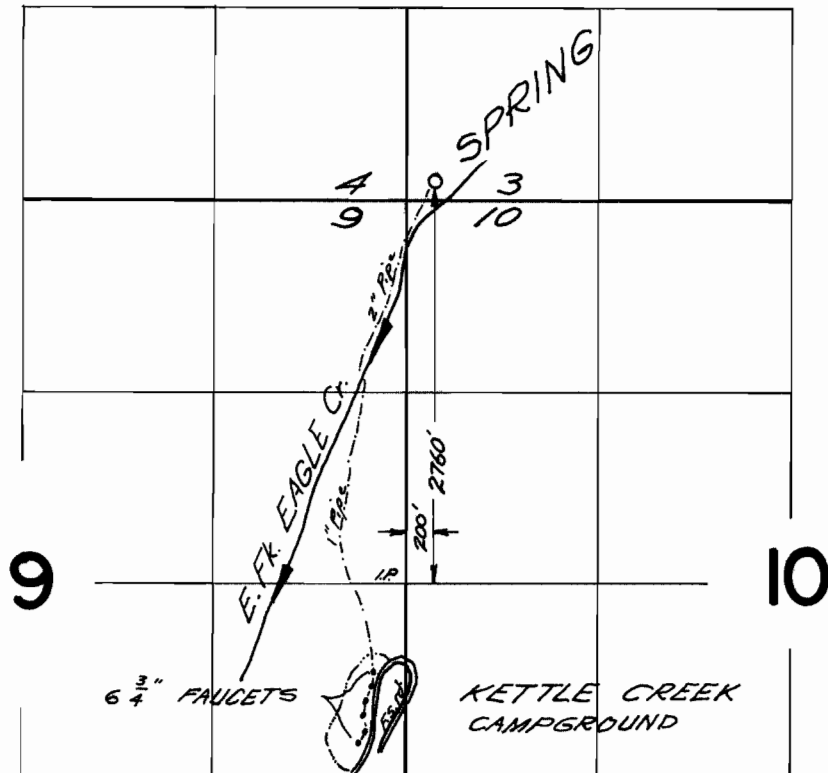

FINAL PROOF SURVEY UNDER

Application No. 39893 Permit No. 30042
IN NAME OF
U.S. DEPT. OF AGRICULTURE
WALLOWA-WHITMAN NATIONAL FOREST

Surveyed Aug 5 1966, by V. GARNER